

MISSISSIPPI BOARD OF WATER COMMISSIONERS

WATER WELL DRILLERS LOG

**CODED**

LAUD.  
J 60  
10-64

Date: Oct, 1964 Driller: Peoples Drill Co. County Landover  
(Name)

	Description & Color of Materials Sand, Clay, Red Clay, Shell, etc.	Thick- ness Feet	Depth Feet
(1) Owner of Land: <u>St. Comm. Hail Faye</u> (Name) <u>NAAS</u> (Address)	<u>Yellow sand &amp; Sclay</u>	<u>12</u>	<u>12</u>
(2) Location: <u>1 N 17</u> <u>Dalewood Shore Lakes</u> miles <u>          </u> , of <u>          </u> (distance) (direction) (Nearest Town)	<u>Blue wash</u> <u>White to Gray sand</u>	<u>19</u> <u>17</u>	<u>31</u> <u>48</u>
(3) Topography: <u>Hilly to flat</u> (Hilly) (Flat) (Level)			
(4) Purpose of Well: (Domestic Irrigation Municipal, Industrial, Other)			

**CODED**

Information upon completion of well:

(1) Diameter 2 inches.

(2) Total Depth 48 feet.

(3) Water Level 10 feet below top of ground.

(4) Cased to 42', Size 2"


(5) Screen: Size 2", Length 6'

(6) Were any formations sealed against pollution?  
\_\_\_\_\_ yes, \_\_\_\_\_ no.

If YES depth of formation \_\_\_\_\_

Why \_\_\_\_\_

Drillers Remarks: \_\_\_\_\_

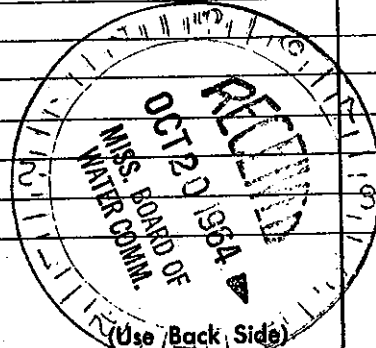

Well No. \_\_\_\_\_

Mail this copy to Board of Water Commissioners 429 Miss. St. Jackson, Mis.