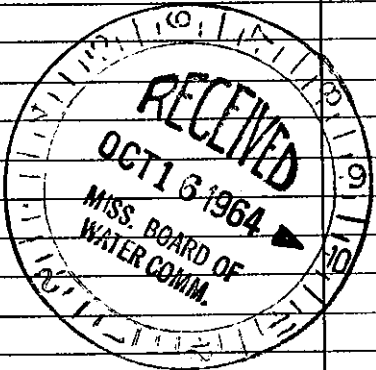


LAUD. MISSISSIPPI BOARD OF WATER COMMISSIONERS

J61
10-8-64
Date: 10. 8, 1964

WATER WELL DRILLERS LOG **CODED**

Driller: MCDONALD - Hilly County Lauderdale
(Name)

(1) Owner of Land: <u>TOMMY LEE REED</u> (Name)	Description & Color of Materials Sand, Clay, Red Clay, Shell, etc.	Thick- ness Feet	Depth Feet
<u>TOOMASUBA MISS</u> (Address)	CLAY	0	30
(2) Location: <u>24 7 17</u> T. R. _____ miles _____ of _____ (distance) (direction) (Nearest Town)	SHALE	30	140
(3) Topography: <u>X</u> (Hilly) (Flat) (Level)	SANDY	140	160
(4) Purpose of Well: <u>DOMESTIC</u> (Domestic Irrigation, Municipal, Industrial, Other)	SHALE	160	205
Information upon completion of well:	FINE SAND	205	225
(1) Diameter: <u>3 1/4</u> inches. <u>TEST HOLE</u>	SHALE	225	318
(2) Total Depth: <u>330</u> feet.	SAND	318	330
(3) Water Level: <u>160</u> feet below top of ground.	CODED 		
(4) Cased to: <u>322</u> feet, Size <u>2</u> "			
(5) Screen: Size <u>2</u> " Length <u>8</u> ' <u>GRASS</u>			
(6) Were any formations sealed against pollution? _____ yes, _____ no.			
If YES depth of formation _____			
Why _____			
Drillers Remarks: _____			

(Use Back Side)

Well No.

Mail this copy to Board of Water Commissioners 429 Miss. St. Jackson, Mis: