

LAUDERDALE
 J 115
 2-14-75

MISSISSIPPI
 BOARD OF WATER COMMISSIONERS
 416 North State Street
 Jackson, Mississippi 39201

WATER WELL DRILLERS LOG

2-14 date well completed
 1975 McDonald & Hill Inc firm name
 Lauderdale county well located


LANDOWNER	description of formations encountered	from	to
Sidney Porter Rt 1	Clay & Sand	0	39
Thomas, Miss (mailing address)	Shale	39	50
	Coarse Sand	50	83
	Sandy	83	130
	Coarse Sand	130	160
	St fine Sand	160	180
	Coarse sand	180	213

WELL LOCATION:
sec. 11 T. 7 N. R. 17 E
4 miles north of Town
(distance) (direction) (nearest town)

WELL PURPOSE:
Home
(home, irrigation, municipal, industrial)

WELL COMPLETION DATA:
(1) diameter (inches) 4"
(2) total depth (feet) 213'
(3) static water level (feet) 40 below top of ground.
(4) casing 4" PVC 165' (material) (depth)
2" (size) If telescope see back.
(5) screen 5' 208' (length) (depth to top)
2" Plastic (size) (material)
(6) pump No (HP) (yield gpm)
(type power)
(7) electric log No (yes or no)
(organization running log)
(8) how well bottom plugged back pressure valve

DRILLERS REMARKS: none

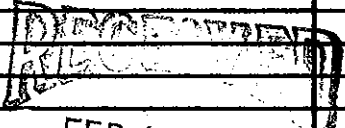

FEB 19 1975

MISS. BD. OF WATER COM