

Landowner date
 J124
 12-15-79

MISSISSIPPI
 BOARD OF WATER COMMISSIONERS
 416 North State Street
 Jackson, Mississippi 39201

WATER WELL DRILLERS LOG

WOODBR2

12/15/79 date well completed 1979 firm name Jany Drilling Co county well located Land


LANDOWNER:	description of formations encountered	from	to
Russell utilities	Red + yellow sand	0	90
Russell, Miss (mailing address)	Sand + clay	90	110
	sand-clay-Rock	110	131
	blue clay	131	303
	clay + rubble	303	519
	clay	519	541
	sandy	541	583
	fine sand	583	625
	coarse sand	625	665

WELL LOCATION:
sec 30 T 7 N R 17 E S W
3 miles NW of Russell (distance) (direction) (nearest town)

WELL PURPOSE:
(home, irrigation, municipal, industrial)

WELL COMPLETION DATA:
(1) diameter (inches) 6"
(2) total depth (feet) 665
(3) static water level (feet) 309 below top of ground
(4) casing steel (material) (depth) 620'
4 (size) If telescope see back.
(5) screen 40 (length) 625' (depth to top) 4" casing
4 (size) stainless steel (material)
(6) pump 20 (HP) 170 (yield gpm)
Sub (type power)
(7) electric log yes (yes or no)
MBS (organization running log)
(8) how well bottom plugged Wash + blue

DRILLERS REMARKS:
Well produced 209 gpm drawdown

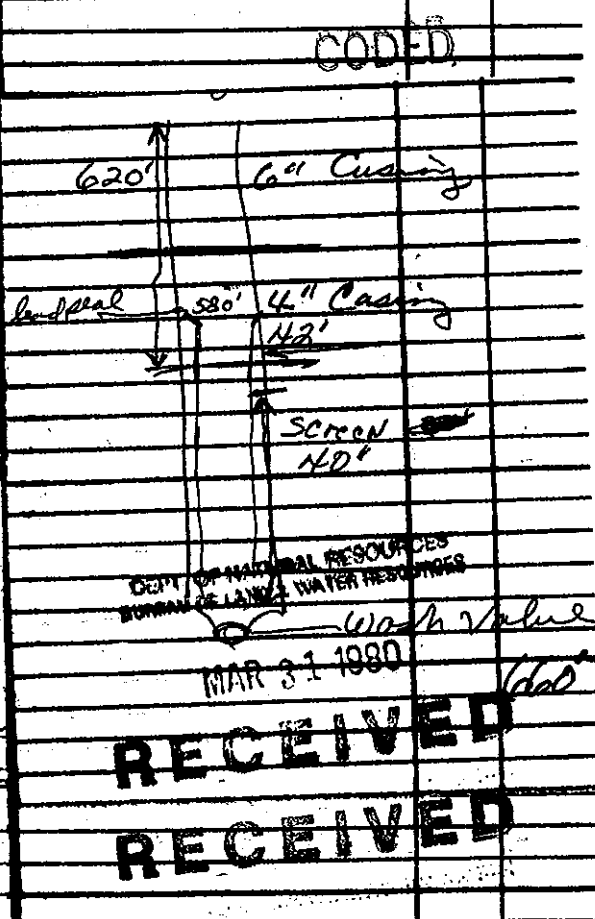

DEPT. OF NATURAL RESOURCES
 BUREAU OF LAND & WATER RESOURCES

Wash value
 MAR 31 1980
 RECEIVED
 RECEIVED