


LAUDERDALE
J 2038
3-10-81
3-10-81

MISSISSIPPI
 BOARD OF WATER COMMISSIONERS
 416 North State Street
 Jackson, Mississippi 39201

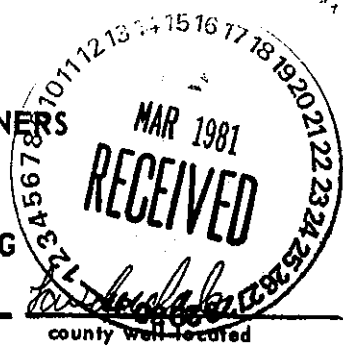

WATER WELL DRILLERS LOG
McDonald & Hill
 firm name

date well completed

county well located

| LANDOWNER: | description of formations encountered | from | to |
|--|---------------------------------------|-----------|------------|
| | | | |
| <u>Clyde Picketts</u> | <u>clay</u> | <u>0</u> | <u>12</u> |
| <u>Dalewood</u> Lot 1956 (mailing address) | <u>sand</u> | <u>12</u> | <u>22</u> |
| WELL LOCATION: sec. <u>1</u> T. <u>7</u> N. R. <u>12</u> E <u>2</u> miles <u>S</u> of <u>Lauderdale</u> (distance) (direction) (nearest town) | <u>shale</u> | <u>22</u> | <u>40</u> |
| WELL PURPOSE: <u>home</u> (home, irrigation, municipal, industrial) | <u>shale & st sand</u> | <u>40</u> | <u>62</u> |
| WELL COMPLETION DATA: (1) diameter (inches) <u>9"</u> | <u>rock</u> | <u>62</u> | <u>70</u> |
| (2) total depth (feet) <u>115'</u> | <u>shale</u> | <u>70</u> | <u>85</u> |
| (3) static water level (feet) <u>10'</u> below above top of ground. | <u>sand & shale</u> | <u>85</u> | <u>115</u> |
| (4) casing <u>PVC</u> <u>110'</u> (material) (depth) | | | |
| <u>9</u> (size) If telescope see back. | | | |
| (5) screen <u>5'</u> <u>110' to 115'</u> (length) (depth to top) | | | |
| <u>9</u> (size) <u>PVC</u> (material) | | | |
| (6) pump <u>1/2</u> <u>6 gpm</u> (HP) (yield gpm) | | | |
| <u>F</u> (type power) | | | |
| (7) electric log <u>—</u> (yes or no) | | | |
| <u>—</u> (organization running log) | | | |
| (8) how well bottom plugged <u>value</u> | | | |
| DRILLERS REMARKS: | | | |

