

LAUD. MISSISSIPPI BOARD OF WATER COMMISSIONERS

K9

8-30-63

WATER WELL DRILLERS LOG

Date: 8-30, 1963, Driller: me. Donald Hill County Lauderdale
 (Name)

(1) Owner of Land: Ray Fowler
 (Name)
Rt. #1, Lauderdale
 (Address) ms 55

(2) Location: 1/4, 1/4, Sec. 30 7N 18E
3 miles west of Keenesee
 (distance) (direction) (Nearest Town)

(3) Topography: Hilly
 (Hilly) (Flat) (Level)

(4) Purpose of Well: Domestic
 (Domestic Irrigation
 Municipal, Industrial, Other)

Description & Color of Materials Sand, Clay, Red Clay, Shell, etc.	Thick- ness Feet	Depth Feet
<u>Clay</u>	<u>0</u>	<u>18</u>
<u>sand</u>	<u>18</u>	<u>21</u>
<u>shale</u>	<u>21</u>	<u>40</u>
<u>shale w/ade. bicolor</u>	<u>40</u>	<u>50</u>
<u>shale</u>	<u>50</u>	<u>108</u>
<u>gray shaded sd.</u>	<u>108</u>	<u>111</u>
<u>sd. w/ thin shale</u>	<u>111</u>	<u>151</u>
<u>traverse</u>		

Information upon completion of well:

(1) Diameter 3 7/8 inches.

(2) Total Depth 151 feet.

(3) Water Level 65 feet below top of ground.

(4) Cased to 145, Size 4 x 2.


(5) Screen: Size 2", Length 6'.

(6) Were any formations sealed against pollution?
 _____ yes, _____ no.

If YES depth of formation _____

Why _____

Drillers Remarks: _____

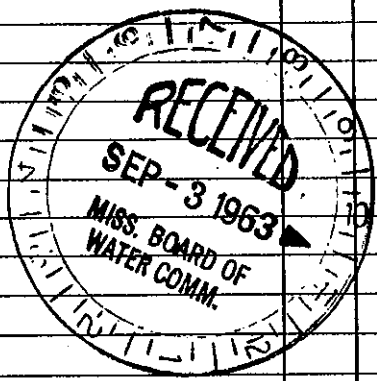

Well No.
103

(Use Back Side)

Mail this copy to Board of Water Commissioners: 429 Miss. St. Jackson, Miss.