

LAUD. MISSISSIPPI BOARD OF WATER COMMISSIONERS

K 10

9-26-63

WATER WELL DRILLERS LOG


Date: 9.26, 1963, Driller: McDonald Hill County _____
 (Name)

(1) Owner of Land: The Texas Co.
 (Name)
Kennerly, Miss
 (Address)
 (2) Location: 1/4, 1/4, Sec 28 7N 18E
1 miles west, of Kennerly
 (distance) (direction) (Nearest Town)
 (3) Topography: X
 (Hilly) (Flat) (Level)
 (4) Purpose of Well: SERVICE STATION
 (Domestic Irrigation
 Municipal, Industrial, Other)

Description & Color of Materials Sand, Clay, Red Clay, Shell, etc.	Thick- ness Feet	Depth Feet
CLAY	0	20
SAND	20	30
SHALE	30	80
SHALE ST SAND	80	105
FINE SAND	105	140
SAND	140	170

Information upon completion of well:

(1) Diameter 4" inches.
 (2) Total Depth 170' feet.
 (3) Water Level 14' feet below top of ground.
 (4) Cased to 100', Size 4"
 (5) Screen: Size 2, Length 6'
75' 2"
 (6) Were any formations sealed against pollution?
 _____ yes, _____ no.

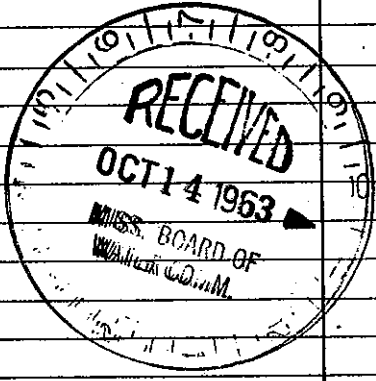

If YES depth of formation _____
 Why _____
 Drillers Remarks: _____

Well No.

(Use Back Side)