

Lauderdale MISSISSIPPI BOARD OF WATER COMMISSIONERS

K12
8-66

WATER WELL DRILLERS LOG

Date: 28/8, 1966, Driller: Jerry Drey
SCARBROOK County LAud
(Name)

(1) Owner of Land: <u>MRS RUTH THOMAS</u> (Name)	Description & Color of Materials Sand, Clay, Red Clay, Shell, etc.	Thick- ness Feet	Depth Feet
<u>TOOMSUBA, MISS</u> (Address)	<u>YELLOW CLAY</u>	<u>20</u>	<u>20</u>
(2) Location: <u>SW 1/4, SW 1/4, Sec 21 T28N R1E</u> <u>13</u> miles <u>E</u> , of <u>MDN</u> (distance) (direction) (Nearest Town)	<u>SANDY</u>	<u>30</u>	<u>50</u>
	<u>SAUDY SHALE</u>	<u>40</u>	<u>90</u>
	<u>SHALE</u>	<u>50</u>	<u>140</u>
	<u>WHITE SAND</u>	<u>28</u>	<u>168</u>
(3) Topography: <u>(Flat)</u> (Hilly) (Flat) (Level)			
(4) Purpose of Well: <u>DOMESTIC</u> (Domestic Irrigation Municipal, Industrial, Other)			


Information upon completion of well:

- (1) Diameter 4 inches.
- (2) Total Depth 168 feet.
- (3) Water Level 18' feet below top of ground.
- (4) Cased to 147, Size 4"
- (5) Screen: Size 2", Length 6'
- (6) Were any formations sealed against pollution?
_____ yes, _____ no.

If YES depth of formation _____

Why _____

Drillers Remarks: _____

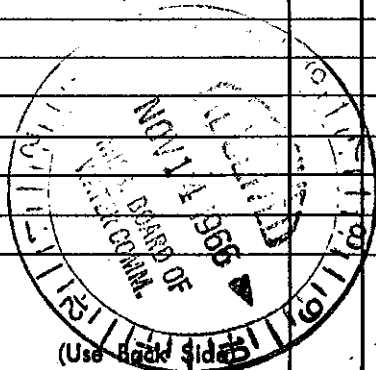

Well No. _____

(Use Back Side)