

Lauderdale MISSISSIPPI BOARD OF WATER COMMISSIONERS

K 13
8-66

WATER WELL DRILLERS LOG

Date: Aug 24, 1966, Driller: Jerry Drg. Co
SCARBROUGH County Laud

(1) Owner of Land	Description & Color of Materials Sand, Clay, Red Clay, Shell, etc.	Thick- ness Feet	Depth Feet
<u>HUNTER BLANKS</u> (Name)			
<u>TOOMSUBA, MISS</u> (Address)	<u>YELLOW SAND</u>	<u>35</u>	<u>35</u>
(2) Location <u>SE 1/4, NW 1/4, Sec. 29 T19N R18E</u>	<u>BLACK SHALE</u>	<u>65</u>	<u>100</u>
<u>12</u> miles <u>E</u> , of <u>MDN</u> (distance) (direction) (Nearest Town)	<u>SANDY SHALE</u>	<u>30</u>	<u>130</u>
(3) Topography: <u>(Flat)</u> (Hilly) (Flat) (Level)	<u>SHALE</u>	<u>20</u>	<u>150</u>
(4) Purpose of Well: <u>DOMESTIC</u> (Domestic Irrigation Municipal, Industrial, Other)	<u>SAND - COARSE</u>	<u>42</u>	<u>192</u>

Information upon completion of well:

(1) Diameter 4 inches.

(2) Total Depth 192 feet.

(3) Water Level 25 feet below top of ground.

(4) Cased to 152', Size 4"


(5) Screen: Size 2", Length 6"

(6) Were any formations sealed against pollution?
_____ yes, _____ no.

If YES depth of formation _____

Why _____

Drillers Remarks: _____

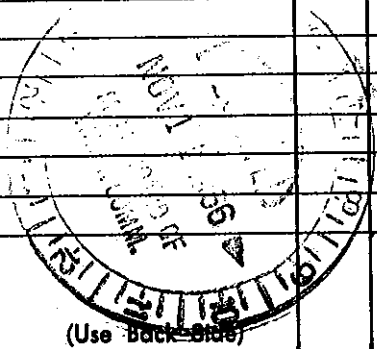

(Use Back Side)

Well No.

Mail this copy to Board of Water Commissioners 429 Miss. St. Jackson, Miss.