

LAUD. MISSISSIPPI BOARD OF WATER COMMISSIONERS

~~K14~~
7-25-60

WATER WELL DRILLERS LOG

Date: 7/25, 1960, Driller: M. Donnelly, 1st County Lauderdale
(Name)

(1) Owner of Land: Johnny Glasall
(Name)
Tosmanville miss
(Address)

(2) Location: 1/4, 1/4, Sec. 19 7N17E
T R
_____ miles _____ of _____
(distance) (direction) (Nearest Town)

(3) Topography: _____
(Hilly) (Flat) (Level)

(4) Purpose of Well: Domestic
(Domestic Irrigation
Municipal, Industrial, Other)

Description & Color of Materials Sand, Clay, Red Clay, Shell, etc.	Thick- ness Feet	Depth Feet
Clay + Sand	0	38
marl + sandy marl	38	85
Brackish marl	85	100
marl	100	120
Sandy shell	120	128
marl	128	147
Sandy shell + marl	147	205
Course sand	205	220

Information upon completion of well:

(1) Diameter 2 inches.


(2) Total Depth 220 feet.

(3) Water Level 115 feet below top of ground.

(4) Cased to 220, Size _____

(5) Screen: Size 2", Length 5

(6) Were any formations sealed against pollution?
_____ yes, no.

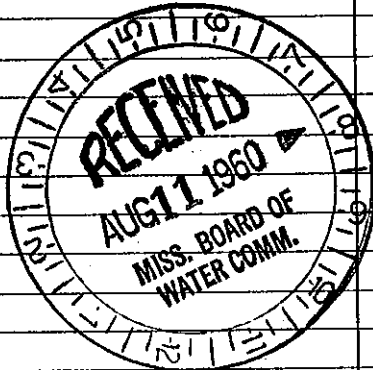

If YES depth of formation _____
Why _____
Drillers Remarks: _____

Well No.

(Use Back Side)