

LAUD. MISSISSIPPI BOARD OF WATER COMMISSIONERS

K15  
7-11-63


**WATER WELL DRILLERS LOG**

Date: 7-11, 1963, Driller: M. Donald & Hill County Lauderdale  
(Name)

(1) Owner of Land: <u>Stucky's</u> (Name)	Description & Color of Materials Sand, Clay, Red Clay, Shell, etc.	Thick- ness Feet	Depth Feet
<u>Rt #1, Tomsuba, Miss</u> (Address)	<u>SAND ST CLAY</u>	<u>0</u>	<u>30</u>
	<u>SHALE</u>	<u>30</u>	<u>50</u>
(2) Location: <u>1/4</u> , <u>1/4</u> , Sec. <u>8</u> <u>7N17E</u> T R	<u>ROCK</u>	<u>50</u>	<u>52</u>
<u>15</u> miles <u>EAST</u> , of <u>Meridian</u> (distance) (direction) (Nearest Town)	<u>SHALE</u>	<u>52</u>	<u>78</u>
(3) Topography: <u>X</u> (Hilly) (Flat) (Level)	<u>SAND</u>	<u>78</u>	<u>90</u>
(4) Purpose of Well: <u>DOMESTIC</u> (Domestic Irrigation Municipal, Industrial, Other)	<u>SHALE</u>	<u>90</u>	<u>94</u>
	<u>SAND ST SHALE</u>	<u>94</u>	<u>105</u>
	<u>SAND NO 10</u>	<u>105</u>	<u>130</u>
	<u>SAND NO 14</u>	<u>130</u>	<u>160</u>

Information upon completion of well:

- (1) Diameter 3 3/4 inches. TEST HOLE REAMED TO 6" FOR CASING
- (2) Total Depth 160' feet.
- (3) Water Level 2' feet below top of ground.
- (4) Cased to 145', Size 4"  
10" = 2"
- (5) Screen: Size 2 1/2, Length 12'
- (6) Were any formations sealed against pollution?  
\_\_\_\_\_ yes, \_\_\_\_\_ no.

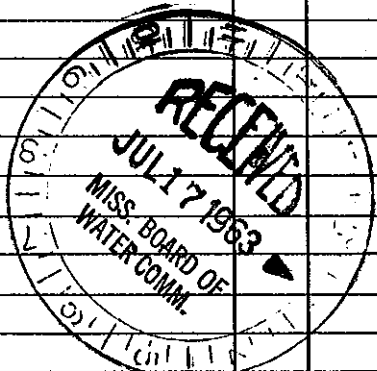

If YES depth of formation \_\_\_\_\_  
Why \_\_\_\_\_  
Drillers Remarks: \_\_\_\_\_

(Use Back Side)

Well No.

Mail this copy to Board of Water Commissioners 429 Miss. St. Jackson, Miss.