

LAUDERDALE
K 17
2-68

MISSISSIPPI
BOARD OF WATER COMMISSIONERS
416 North State Street
Jackson, Mississippi 39201

WATER WELL DRILLERS LOG

2-1-1968 Jerry Drilling Land
date well completed firm name county well located

LANDOWNER:

DX Oil Company
Kewanee, Miss
(mailing address)

description of formations encountered

from to

description of formations encountered	from	to
yellow clay & sand	0	20
blue dirt	20	100
coarse sand	100	161

WELL LOCATION:


sec 27 T 7 N R 18 E
14 miles E-NE of MDN
(distance) (direction) (nearest town)

WELL PURPOSE:

(home, irrigation, municipal, industrial)

WELL COMPLETION DATA:

- (1) diameter (inches) 4"
- (2) total depth (feet) 161'
- (3) static water level (feet) 7 below top of ground.
- (4) casing (material) Blk (depth) 84'
2" If telescope see back. (size)
- (5) screen (length) 10', (depth to top) 151'
2" Stainless Steel (size) (material)
- (6) pump (HP) 1 (yield gpm) 35
Schmager (type power)
- (7) electric log NO (yes or no)
(organization running log)
- (8) how well bottom plugged Wash Valve

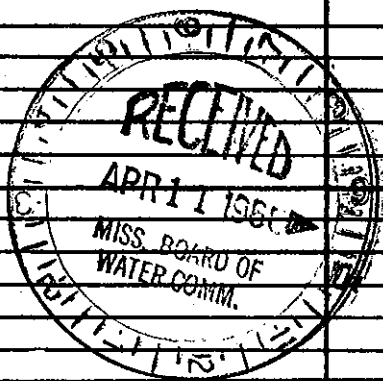

DRILLERS REMARKS: Well pumped 30 gpm with air