

Lauderdale
K 31
7-67

MISSISSIPPI
BOARD OF WATER COMMISSIONERS
416 North State Street
Jackson, Mississippi 39201

CODED

WATER WELL DRILLERS LOG

date well completed 19 MCDONALD + HILL firm name LAUDERDALE county well located

LANDOWNER: WEIGHT STATION
KEWANEE MISS
(mailing address)

WELL LOCATION:
sec. 27 T. 7 N. R. 18 E


(distance) miles (direction) of (nearest town)

WELL PURPOSE: HOME
(home, irrigation, municipal, industrial)

WELL COMPLETION DATA:

- (1) diameter (inches) 3 1/2 TESTHOLE
- (2) total depth (feet) 180'
- (3) static water level (feet) _____ below above top of ground.
- (4) casing GALV, 160',
(material) (depth)
No if telescope see back.
(size)
- (5) screen 6', 160'
(length) (depth to top)
2", STEEL
(size) (material)
- (6) pump 3/4 JET 6
(HP) (yield gpm)
230
(type power)
- (7) electric log NO
(yes or no)
(organization running log)
- (8) how well bottom plugged VALUE

description of formations encountered	from	to
<u>CLAY</u>	<u>0</u>	<u>5</u>
<u>YELLOW SAND</u>	<u>5</u>	<u>45</u>
<u>SHALE</u>	<u>45</u>	<u>84</u>
<u>ROCK</u>	<u>84</u>	<u>88</u>
<u>SHALE</u>	<u>88</u>	<u>125</u>
<u>FINE SAND ST SHALE</u>	<u>125</u>	<u>150</u>
<u>SAND</u>	<u>150</u>	<u>180</u>

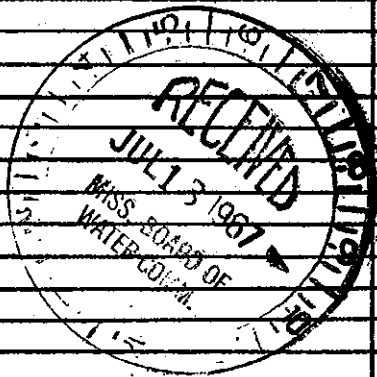

CODED

DRILLERS REMARKS: