

MISSISSIPPI BOARD OF WATER COMMISSIONERS

LAUD.

K 36
7-21-60

WATER WELL DRILLERS LOG

CODED

K 301

Date: 7/21, 1960, Driller: W. R. Donald & Hill County: Lauderdale
(Name)

(1) Owner of Land: Security Buildings
(Name)
Meridian, Miss.
(Address)
29 4-18
(2) Location: 1/4, 1/4, Sec. T, R. R
1 miles East, of Transub
(distance) (direction) (Nearest Town)
(3) Topography: Hilly
(Hilly) (Flat) (Level)
(4) Purpose of Well: Domestic
(Domestic Irrigation
Municipal, Industrial, Other)


Description & Color of Materials Sand, Clay, Red Clay, Shell, etc.	Thick- ness Feet	Depth Feet
<u>Clay + Sand</u>	<u>0</u>	<u>20</u>
<u>Sand + marl sh.</u>	<u>20</u>	<u>55</u>
<u>Marl + lime st.</u>	<u>55</u>	<u>235</u>
<u>Course sand + marl st.</u>	<u>235</u>	<u>260</u>

CODED

Information upon completion of well:

(1) Diameter 2 inches.
(2) Total Depth 260 feet.
(3) Water Level 56 feet below top of ground.
(4) Cased to 105, Size 2 In.
(5) Screen: Size _____, Length _____
(6) Were any formations sealed against pollution?
✓ yes, ✓ no.

if YES depth of formation _____
Why _____
Drillers Remc _____

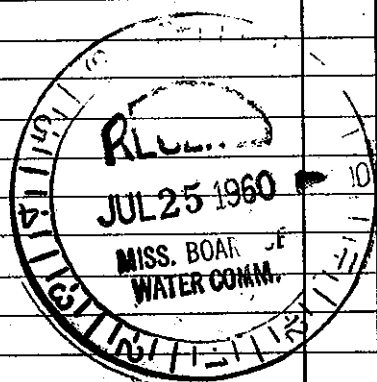

Well No.

(Use Back Side)