

LHUD  
K37  
7-21-60

MISSISSIPPI BOARD OF WATER COMMISSIONERS

WATER WELL DRILLERS

**CODED** K 300

Date: 7/21, 1960, Driller: M. McDonald & Hill County Lauderdale  
(Name)

(1) Owner of Land: Security Building Co.  
(Name)  
Memphis, Miss.  
(Address)  
29 718  
(2) Location: 1/4, 1/4, Sec. T R,  
1 miles East, of Leaksville  
(distance) (direction) (Nearest Town)  
(3) Topography: HILLY  
(Hilly) (Flat) (Level)  
(4) Purpose of Well: Domestic  
(Domestic Irrigation  
Municipal, Industrial, Other)


Description & Color of Materials Sand, Clay, Red Clay, Shell, etc.	Thick- ness Feet	Depth Feet
<u>Clay + Sand</u>	<u>0</u>	<u>20</u>
<u>Sand + marl st.</u>	<u>20</u>	<u>95</u>
<u>Brown marl</u>	<u>95</u>	<u>105</u>
<u>Sandy shell + fine sand</u>	<u>105</u>	<u>190</u>
<u>marl</u>	<u>190</u>	<u>200</u>

Information upon completion of well:

(1) Diameter 2 inches.  
(2) Total Depth 200 feet.  
(3) Water Level 36 feet below top of ground.  
(4) Cased to 95, Size 2"  
(5) Screen: Size \_\_\_\_\_, Length \_\_\_\_\_  
(6) Were any formations sealed against pollution?  
no yes,  no.

If YES depth of formation \_\_\_\_\_  
Why \_\_\_\_\_  
Drillers Remarks: \_\_\_\_\_

**CODED**

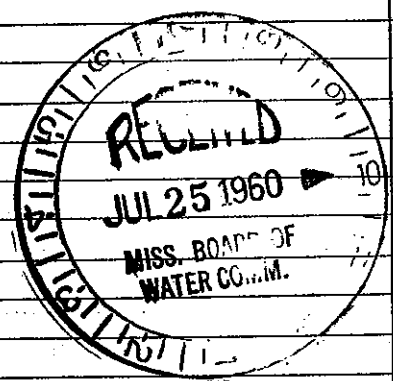

Well No.

(Use Back Side)

Mail this copy to Board of Water Commissioners 429 Miss. St. Jackson, Miss.