

LAUD.
K 39
9-28-61

MISSISSIPPI COMMISSIONERS


WATER WELL DRILLERS

CODED J or O

Date: 9.28, 1961, Driller McDONALD HILL County AUDERDALE
(Name)

	Description & Color of Materials Sand, Clay, Red Clay, Shell, etc.	Thick- ness Feet	Depth Feet
(1) Owner of Land: <u>LEOP JELLECE</u> (Name)	<u>CLAY</u>	<u>0</u>	<u>10</u>
<u>RUSSELL MISS</u> (Address)	<u>SAND</u>	<u>10</u>	<u>22</u>
(2) Location: <u>1/4, 1/4, Sec. 7, T. 18, R. 18</u>	<u>SAND ST CLAY</u>	<u>22</u>	<u>42</u>
<u>8</u> miles <u>EAST</u> of <u>MERIDIAN</u> (distance) (direction) (Nearest Town)	<u>SHALE</u>	<u>42</u>	<u>145</u>
(3) Topography: <u>X</u> (Hilly) (Flat) (Level)	<u>LIGNITE</u>	<u>145</u>	<u>147</u>
(4) Purpose of Well: <u>DOMESTIC</u> (Domestic Irrigation, Municipal, Industrial, Other)	<u>SHALE</u>	<u>147</u>	<u>180</u>
Information upon completion of well:	<u>LIGNITE</u>	<u>180</u>	<u>185</u>
(1) Diameter: <u>4"</u> inches.	<u>SOFT SHALE</u>	<u>185</u>	<u>220</u>
(2) Total Depth: <u>360'</u> feet.	<u>SANDY SHALE LIGNITE</u>	<u>220</u>	<u>231</u>
(3) Water Level: <u>185'</u> feet below top of ground.	<u>SOFT TO MED SHALE</u>	<u>231</u>	<u>295</u>
(4) Cased to: <u>250'</u> , Size <u>4"</u>	<u>FINE SAND ST SHALE</u>	<u>295</u>	<u>310</u>
(5) Screen: Size _____, Length _____	<u>SOFT SHALE</u>	<u>310</u>	<u>314</u>
(6) Were any formations sealed against pollution? _____ yes, _____ no.	<u>SAND</u>	<u>314</u>	<u>320</u>
If YES depth of formation _____	<u>SANDY SHALE</u>	<u>320</u>	<u>335</u>
Why _____	<u>FINE SAND</u>	<u>335</u>	<u>342</u>
Drillers Remarks: _____	<u>SANDY SHALE</u>	<u>342</u>	<u>360</u>

CODED

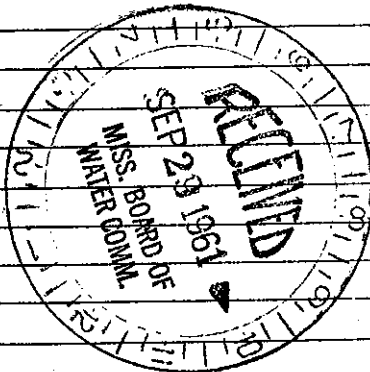

(Use Back Side)

Well No.

Retain this copy for your office files.