

LAUD.

MISSISSIPPI BOARD OF WATER COMMISSIONERS

K 40
6-2-62

WATER WELL DRILLERS LOG

CODED

Date: 6-2, 1962, Driller: Mc Donald & Hill County Lauderdale
(Name)


(1) Owner of Land	Description & Color of Materials Sand, Clay, Red Clay, Shell, etc.	Thick- ness Feet	Depth Feet
<u>Timarie Ray Johnston</u> (Name)	<u>Clay</u>	<u>0</u>	<u>10</u>
<u>Rt. #6 Meridian Miss.</u> (Address)	<u>Sandy Clay</u>	<u>10</u>	<u>30</u>
(2) Location: <u>23</u> <u>718</u> 1/4, Sec. T R	<u>Shale</u>	<u>30</u>	<u>90</u>
<u>6</u> miles <u>East</u> of <u>Meridian</u> (distance) (direction) (Nearest Town)	<u>Sandy</u>	<u>90</u>	<u>110</u>
(3) Topography: <u>Hilly</u> (Hilly) (Flat) (Level)	<u>Shale</u>	<u>110</u>	<u>185</u>
(4) Purpose of Well: <u>Domestic</u> (Domestic Irrigation Municipal, Industrial, Other)	<u>Sandy</u>	<u>135</u>	<u>145</u>
	<u>Shale</u>	<u>145</u>	<u>235</u>
	<u>Sand</u>	<u>235</u>	<u>250</u>
	<u>Sandy Shale</u>	<u>257</u>	<u>260</u>

Information upon completion of well:

- (1) Diameter 3 inches.
- (2) Total Depth ~~149~~ 260 feet.
- (3) Water Level 175 feet below top of ground.
- (4) Cased to 126, Size 3"
- (5) Screen: Size None, Length _____
- (6) Were any formations sealed against pollution?
_____ yes, no.

If YES depth of formation _____
Why _____
Drillers Remarks: _____

CODED

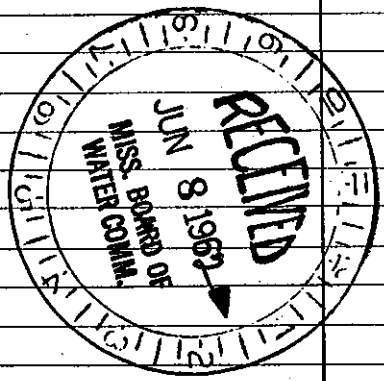

Well No.

(Use Back Side)