


LAUDERDALE
K 2006
2-27-81
2-27-81 19

MISSISSIPPI
 BOARD OF WATER COMMISSIONERS
 416 North State Street
 Jackson, Mississippi 39201
 WATER WELL DRILLERS LOG

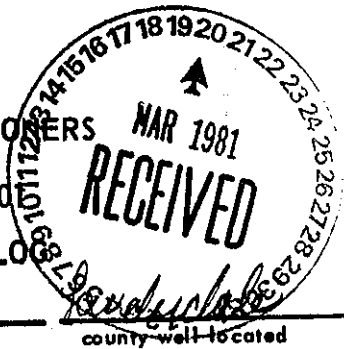

McDonald's Well Lauderdale
 firm name county well located

LANDOWNER:	description of formations encountered	from	to
<u>Jim Spies</u>	<u>clay & sand</u>	<u>2</u>	<u>28</u>
<u>P.O. Box 26, Toomsula</u> (mailing address)	<u>shale & lignite</u>	<u>28</u>	<u>50</u>
WELL LOCATION: sec. <u>20</u> T. <u>7</u> N. R. <u>14</u> E. <u>1 1/2</u> miles <u>E</u> of <u>Toomsula</u> (distance) (direction) (nearest town)	<u>sandy shale</u>	<u>50</u>	<u>65</u>
WELL PURPOSE: <u>Home</u> (home, irrigation, municipal, industrial)	<u>shale</u>	<u>65</u>	<u>80</u>
WELL COMPLETION DATA: (1) diameter (inches) <u>4"</u> (2) total depth (feet) <u>190'</u> (3) static water level (feet) <u>70'</u> below above top of ground. (4) casing <u>PVC</u> <u>185'</u> (material) (depth) <u>4"</u> if telescope see back. (size) (5) screen <u>5</u> <u>185 to 190'</u> (length) (depth to top) <u>4"</u> <u>PVC</u> (size) (material) (6) pump <u>1/2</u> <u>590 gpm</u> (HP) (yield gpm) <u>E</u> (type power) (7) electric log <u>—</u> (yes or no) (organization running log) (8) how well bottom plugged <u>value</u>	<u>sand</u>	<u>80</u>	<u>105</u>
	<u>shale & sand</u>	<u>105</u>	<u>122</u>
	<u>shale</u>	<u>122</u>	<u>150</u>
	<u>sandy shale</u>	<u>150</u>	<u>165</u>
	<u>mat sand & st shale</u>	<u>165</u>	<u>190</u>
DRILLERS REMARKS:			

