

MISSISSIPPI DEPARTMENT OF NATURAL RESOURCES

Bureau of Land and Water Resources

COUNTY WELL LOCATED <i>Laud</i>	
WELL NUMBER <i>K 2053</i>	CODED
DATE WELL COMPLETED <i>10/12/88</i>	

PERMIT NUMBER <i>0-55</i>
NAME OF DRILLING FIRM <i>TERRY DRILLING</i>
<i>RT 8 Box 28 MDN</i>

P.O. Box 10631
Jackson, Mississippi 39209
WATER WELL DRILLERS LOG

NAME & MAILING ADDRESS OF LANDOWNER <i>Kewanee Fishing Club</i>			
<i>Rt 1</i>			
<i>Josanna, Miss.</i>			
WELL LOCATION: SEC	TOWNSHIP	RANGE	
<i>34</i>	<i>7</i>	<i>18</i>	
	<i>N</i>	<i>S</i>	<i>E</i>
			<i>W</i>
DISTANCE	DIRECTION	NEAREST TOWN	
<i>1 1/2</i> Miles	<i>S</i>	of <i>Kewanee</i>	
OTHER LANDMARK			
WELL PURPOSE: Home, irrigation, Municipal, Industrial, Fish Pond, etc. <i>Fishing Club house</i>			

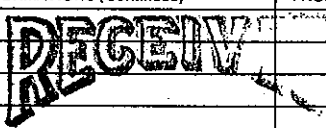
PUMP DATA		
PUMP TYPE (Circle One): Submersible, Turbine, Jet, Flowing Well, Other (Describe) _____		
POWER TYPE (Circle One): Electric, Tractor, Diesel, Gasoline, Butane, Other (Describe) _____		
Pump Capacity (GPM)	No. of Stages	Setting Depth
		FT.
PUMP TEST		
Well yielded _____ GPM with		
a drawdown of _____ ft.		
after _____ hours of pumping		

WELL DATA		
Well Depth <i>178'</i>	Casing Diameter (In.) <i>2"</i>	Casing Length (Ft.) <i>168</i>
Type of Casing <i>PVC</i>	Hole Depth <i>178</i>	Depth to Static Water Level <i>70'</i>
TYPE OF COMPLETION: (Circle One or More): Gravel Packed, Underreamed, Telescoped, <u>Natural Development</u> , Open Hole, Other (Describe) _____		
Top of Lap Pipe or Reduction in Casing		
FEET	IF TELESCOPED OR MORE THAN ONE SCREEN: USE BACK PAGE	

LOG DATA	
TYPE OF LOG RUN (Circle One): No Log Run, Electric, Gamma Ray, Density, Sonic, Neutron, Other (Describe) _____	
Name of Organization Running Log	

SCREEN DATA		
Diameter - Inches <i>2"</i>	Length - Feet <i>10'</i>	Slot Size - Inches <i>10/32</i>
Screen Type <i>wire</i>	Depth to Bottom - Feet <i>178</i>	

GEOLOGIC DATA (Office Use Only)			
Surface Elev.	Geologic Unit	Unit Thickness	Depth to Top
Subs. SWL	Date	Analysis	Aquifer Test
Driller's Remarks			

DESCRIPTION OF FORMATIONS ENCOUNTERED	FROM	TO	FORMATIONS (Continued)	FROM	TO
<i>Yellow Clay sand</i>	<i>0</i>	<i>45</i>	 RECEIVED DEC 27 1988 Department of Natural Resources Bureau of Land & Water Resources		
<i>Blue Clay</i>	<i>45</i>	<i>90</i>			
<i>sandy Clay</i>	<i>90</i>	<i>120</i>			
<i>Clay</i>	<i>120</i>	<i>150</i>			
<i>Sand</i>	<i>150</i>	<i>178</i>			

IF MORE SPACE IS NEEDED, USE BACK