

L.A.O.D.  
L2


MISSISSIPPI BOARD OF WATER COMMISSIONERS

M

10-20-61 WATER WELL DRILLERS LOG

Date: 10-20, 1961, Driller: McDonald Hill County: Lauderdale  
(Name)

	Description & Color of Materials Sand, Clay, Red Clay, Shell, etc.	Thick- ness Feet	Depth Feet
(1) Owner of Land: (Name) <u>MEEHAN MISS</u> (Address) <u>286 N 14E</u>	Top Soil	0	3
	SAND	3	18
	SHALE	18	35
(2) Location: $\frac{1}{4}$ , $\frac{1}{4}$ , Sec. <u>28 6N 14E</u> T. R. <u>6</u> miles <u>WEST</u> of <u>MERIDIAN</u> . (distance) (direction) (Nearest Town)	Sand & SHALE	35	85
	SOFT SHALE	85	95
	MED SHALE	95	115
	SAND	115	140
	SANDY SHALE	140	150
(3) Topography: <u>X</u> (Hilly) (Flat) (Level)			
(4) Purpose of Well: <u>DOMESTIC</u> (Domestic Irrigation Municipal, Industrial, Other)			
Information upon completion of well:			
(1) Diameter <u>5 3/4</u> inches.			
(2) Total Depth <u>150'</u> feet.			
(3) Water Level <u>8'</u> feet below top of ground.			
(4) Cased to <u>125'</u> , Size <u>4"</u>			
(5) Screen: Size _____, Length _____			
(6) Were any formations sealed against pollution? _____ yes, _____ no.			
If YES depth of formation _____			
Why _____			
Drillers Remarks: _____			
			Well No.

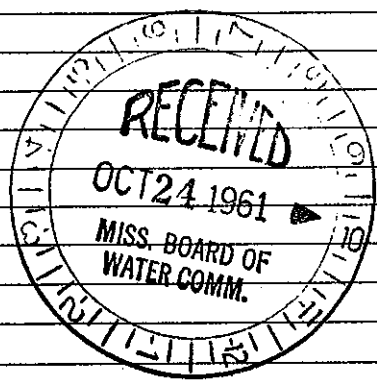

(Use Back Side)

Mail this copy to Board of Water Commissioners 429 Miss. St. Jackson, Miss.