


Vanderdale
LA

8-66

MISSISSIPPI BOARD OF WATER COMMISSIONERS

WATER WELL DRILLERS LOG

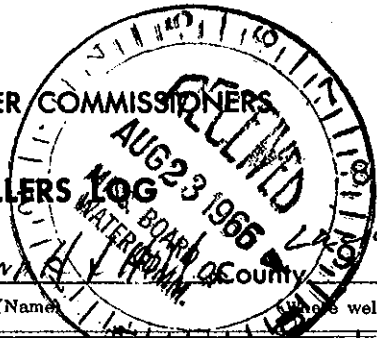

Date: 8-19, 1966, Driller: M. C. Donnelly
 (When well drilled) (Name) (Where well is located)

(1) Owner of Land: <u>W.L. MARTIN</u> (Name)	Description of Color of Materials Sand, Clay, Red Clay, Shell, etc.	Thick- ness Feet	Depth Feet
<u>Rt. 5 Meridian</u> (Address)	<u>CLAY ST/SAND</u>	<u>0</u>	<u>11</u>
(2) Location: <u>NE 1/4, SE 1/4, Sec. 28 T. 14 R. 6 E.</u>	<u>ROCK ST/SHALE</u>	<u>11</u>	<u>50</u>
<u>8</u> miles <u>WEST</u> , of <u>MERIDIAN</u> (distance) (direction) (Nearest Town)	<u>SHALE</u>	<u>50</u>	<u>60</u>
(3) Topography: <u>X</u> (Hilly) (Flat) (Level)	<u>SAND</u>	<u>60</u>	<u>88</u>
(4) Purpose of Well: <u>DOMESTIC</u> (Domestic Irrigation Municipal, Industrial, Other)	<u>SHALE</u>	<u>88</u>	<u>118</u>
Information upon completion of well:	<u>FINE SAND ST/SAND</u>	<u>118</u>	<u>135</u>
(1) Diameter <u>4</u> " inches. <u>well</u>	<u>SHALE</u>	<u>135</u>	<u>145</u>
(2) Total Depth <u>360</u> ' feet.	<u>SHALE</u>	<u>145</u>	<u>200</u>
(3) Water Level <u>35</u> ' feet below top of ground.	<u>SAND</u>	<u>200</u>	<u>212</u>
(4) Cased to <u>242</u> ', Size <u>4</u> "	<u>SOFT SHALE</u>	<u>212</u>	<u>242</u>
(5) Screen: Size <u>None</u> , Length _____	<u>SHALE ST/LIBERTY</u>	<u>242</u>	<u>235</u>
(6) Were any formations sealed against pollution? _____ yes, <u>X</u> no.	<u>SHALE</u>	<u>235</u>	<u>275</u>
If YES depth of formation _____	<u>FINE SAND ST/SHALE</u>	<u>275</u>	<u>324</u>
Why _____	<u>SAND</u>	<u>324</u>	<u>320</u>
Drillers Remarks: _____	<u>SAND ST/SHALE</u>	<u>320</u>	<u>360</u>
Yield in gpm: _____			
Size pump: _____			
Type power: _____			

Retain this copy for your office files.