

LAUD. MISSISSIPPI BOARD OF WATER COMMISSIONERS

L7

6-18-65

WATER WELL DRILLERS LOG

Date: 6-18, 1965, Driller: McDonald & Hill, Inc. County: Lauderdale

(Name)

(1) Owner of Land: J. M. Cochran
 (Name)
Rt # 6 Meridian, Miss.
 (Address)
30 6N14E

(2) Location: 10 miles West of Meridian
 (distance) (direction) (Nearest Town)

(3) Topography: (Hilly) (Flat) (Level)

(4) Purpose of Well: Domestic
 (Domestic Irrigation, Municipal, Industrial, Other)

Description & Color of Materials Sand, Clay, Red Clay, Shell, etc.	Thick- ness Feet	Depth Feet
clay	0	8
blue shale	8	30
br. shale	30	73
H. shale	73	98
sandy shale	98	103
shale	103	118
lig. sand st.	118	123
H. shale	123	130
H. shale lig. st.	130	170
sandy shale	170	175
H. shale	175	200
shale & sandy	200	223
H & M shale	223	246
sandy	246	252
M H shale	252	285
soft sandy shale	285	305
shale & sandy st.	305	330
fine sand & sandstone	330	400

Information upon completion of well:

(1) Diameter 4 inches.

(2) Total Depth 400 feet.

(3) Water Level 200 feet below top of ground.

(4) Cased to 237, Size 4"


(5) Screen: Size _____, Length _____

(6) Were any formations sealed against pollution?
 _____ yes, no.

If YES depth of formation _____

Why _____

Drillers Remarks: _____

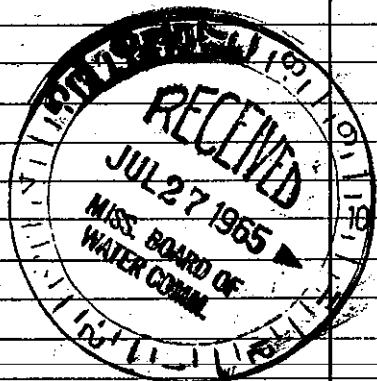

We