

Lauderdale
 L9
 2-67

MISSISSIPPI
 BOARD OF WATER COMMISSIONERS
 416 North State Street
 Jackson, Mississippi 39201
 WATER WELL DRILLERS LOG

2.24.67 19 McDonald Hill LAUDERDALE
 date well completed firm name county well located


LANDOWNER: MASONITE CORP
 MEEHAN MISS
 (mailing address)

WELL LOCATION:
 sec. 28 T 6 N R 14 E
 S W
 3 miles NORTH of MEEHAN
 (distance) (direction) (nearest town)

WELL PURPOSE: HOME
 (home, irrigation, municipal, industrial)

- WELL COMPLETION DATA:
- (1) diameter (inches) 4" WELL
 - (2) total depth (feet) 400
 - (3) static water level (feet) 64 below above top of ground.
 - (4) casing 4" 265'
 (material) (depth)
 NO If telescope see back.
 (size)
 - (5) screen NO NO
 (length) (depth to top)
 NO NO
 (size) (material)
 - (6) pump 1/2 HP Rod 6
 (HP) (yield gpm)
 230
 (type power)
 - (7) electric log NO
 (yes or no)
 (organization running log)
 - (8) how well bottom plugged OPEN

description of formations encountered	from to	
	feet	feet
CLAY	0	10
ROCK ST SHALE	10	40
SAND	60	78
SHALE	78	105
SAND ST SHALE	105	160
SHALE	160	205
SHALE ST SAND	205	255
SHALE	255	295
SOFT SANDY	295	310
SHALE	310	335
SAND	335	342
SHALE	342	355
SAND	355	360
ROCK	362	363
SANDY	363	370
SOFT SHALE	370	400

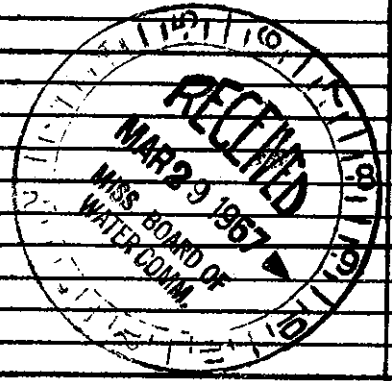

DRILLERS REMARKS: