

Lauderdale  
 L10  
 2-67

MISSISSIPPI  
 BOARD OF WATER COMMISSIONERS  
 416 North State Street  
 Jackson, Mississippi 39201  
 WATER WELL DRILLERS LOG

2, 3, 67 19 McDonald Hill LAUDERDALE  
 date well completed firm name county well located


LANDOWNER: JAMES HARRIS  
 MEEHAN MISS  
 (mailing address)

WELL LOCATION:  
 sec. 28 T 6 N R 14 E  
 S W  
 1/2 miles NORTH of MEEHAN  
 (distance) (direction) (nearest town)

WELL PURPOSE: HOME  
 (home, irrigation, municipal, industrial)

- WELL COMPLETION DATA:
- (1) diameter (inches) 4" WELL
  - (2) total depth (feet) 380'
  - (3) static water level (feet) 100' <sup>(below)</sup> above top of ground.
  - (4) casing Black 262' (material) (depth)  
 4" (size) if telescope see back.
  - (5) screen NO (length) NO (depth to top)  
 NO (size) NO (material)
  - (6) pump 3/4 JET 10 (HP) (yield gpm)  
 230 (type power)
  - (7) electric log NO (yes or no)  
 (organization running log)
  - (8) how well bottom plugged OPEN

description of formations encountered	from	to
CLAY	0	18
SHALE	18	22
ROCK	22	28
SHALE	28	62
SAND ST SHALE	62	98
SHALE	98	140
SAND	140	170
SHALE	170	210
SOFT SHALE ST SAND	210	240
SHALE	240	290
FINE SAND	290	340
SOFT SHALE	340	350
SAND	350	380

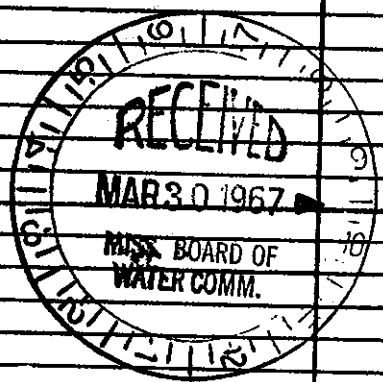

DRILLERS REMARKS: