

MISSISSIPPI BOARD OF WATER COMMISSIONERS

LAUD.

~~112~~ WATER WELL DRILLERS LOG

6-10-64

Date: 6-10, 1964, Driller: Bob Williams County Tadoussac
(Name)

(1) Owner of Land	Description & Color of Materials Sand, Clay, Red Clay, Shell, etc.	Thick- ness Feet	Depth Feet
<u>Widow Pop. Church</u> (Name)	<u>White clay & fine sand</u>	<u>20</u>	<u>1-20</u>
<u>Route # 2, Meridian</u> (Address)	<u>Blue Clay</u>	<u>60</u>	<u>20-80</u>
<u>W 1/4</u>	<u>fine sand</u>	<u>18</u>	<u>80-98</u>
(2) Location: <u>1/4, 1/4, Sec. 2, T. R.</u>	<u>Blue Clay</u>	<u>27</u>	<u>90-117</u>
<u>4</u> miles <u>West</u> of <u>Meridian</u> (distance) (direction) (Nearest Town)	<u>White sand</u>	<u>18</u>	<u>117-135</u>
(3) Topography: <u>Hilly</u> (Hilly) (Flat) (Level)	<u>Blue Clay</u>	<u>17</u>	<u>135-152</u>
(4) Purpose of Well: <u>Domestic</u> (Domestic Irrigation Municipal, Industrial, Other)	<u>Rock</u>	<u>?</u>	<u>152</u>


Information upon completion of well:

- (1) Diameter 2 inches.
- (2) Total Depth 152 feet.
- (3) Water Level 48 feet below top of ground.
- (4) Cased to 110, Size 2"
- (5) Screen: Size 0, Length _____
- (6) Were any formations sealed against pollution?
✓ yes, _____ no.

If YES depth of formation 1-20 feet

Why surface water

Drillers Remarks: _____

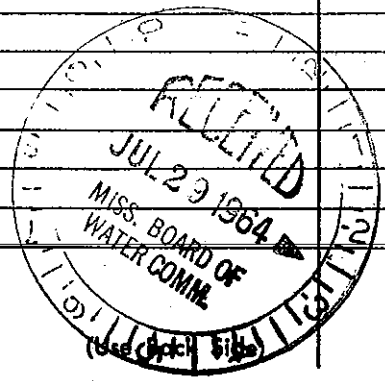

Well No. _____

Retain this copy for your office files.