

LAUD. MISSISSIPPI BOARD OF WATER COMMISSIONERS

L-13

8-8-64

WATER WELL DRILLERS LOG

Date: 8/8, 1964, Driller: Bob Williams - County Lauderdale

(Name)

(1) Owner of Land: Boutwell
(Name)
Rt. 2, Meridian
(Address)

(2) Location: 1/4, 1/4, Sec. 23, T. 16 N, R. 16 E
4 miles West of Meridian
(distance) (direction) (Nearest Town)

(3) Topography: Hilly
(Hilly) (Flag) (Level)

(4) Purpose of Well: Domestic
(Domestic Irrigation
Municipal, Industrial, Other)


Description & Color of Materials Sand, Clay, Red Clay, Shell, etc.	Thick- ness Feet	Depth Feet
Red sand	20	1-20
White sand	20	20-40
Red sand loam		
Water return	50	40-90
Blue clay	35	90-125
gray sand	2.4	125-149

Information upon completion of well:

- (1) Diameter 2 inches.
- (2) Total Depth 149 feet.
- (3) Water Level 79 feet below top of ground.
- (4) Cased to 105, Size 2"
- (5) Screen: Size 0, Length
- (6) Were any formations sealed against pollution?
Yes, no.

If YES depth of formation
Why surface water

Drillers Remarks:

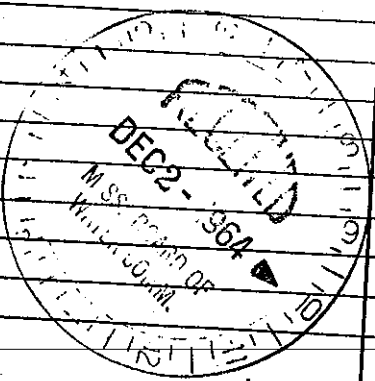

(Use Back Side)

Well No.

tain this copy for your office files.