

LAUD.
 6 L14

WATER WELL DRILLERS LOG

Date: 8-18-64 1964, Driller: M. Donald & Hill Inc County Lauderdale
 (Name)

(1) Owner of Land: DAVID MIXON
 (Name)
17th MERIDIAN
 (Address)
 (2) Location: 1/4, 1/4, Sec. 8 W 1/4 E 1/4
10 miles NW, of Mendenhall
 (distance) (direction) (Nearest Town)
 (3) Topography: V
 (Hilly) (Flat) (Level)
 (4) Purpose of Well: Domestic
 (Domestic Irrigation, Municipal, Industrial, Other)

Description & Color of Materials Sand, Clay, Red Clay, Shell, etc.	Thick- ness Feet	Depth Feet
CLAY	0	15
SHALE	15	45
SAND ST. Clay	45	55
SAND	55	115
SHALE	115	146
ROCK	146	148
SAND	148	162
SHALE	162	275
SAND	275	300

Information upon completion of well:

(1) Diameter 3 7/8 inches. TEST HOLE

(2) Total Depth 300' feet.

(3) Water Level 70' feet below top of ground.

(4) Cased to 170, Size 4"


(5) Screen: Size _____, Length _____

(6) Were any formations sealed against pollution?
 _____ yes, _____ no.

If YES depth of formation _____

Why _____

Drillers Remarks: _____

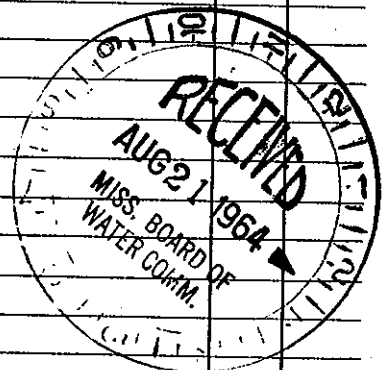

Well No.

(Use Back Side)

Mail this copy to Board of Water Commissioners 429 Miss. St. Jackson, Miss.