

LAUD,
M L 16
3-16-61

MISSISSIPPI BOARD OF WATER COMMISSIONERS

WATER WELL DRILLERS LOG

Date: 3/16, 1961, Driller: Hester Ogletree County, Neshoba
(Name)

(1) Owner of Land: <u>Arthur Hamm</u> (Name)	Description & Color of Materials Sand, Clay, Red Clay, Shell, etc.	Thick- ness Feet	Depth Feet
<u>Meridian, Miss</u> (Address)			
(2) Location: <u>1/4, 1/4, Sec. 25</u> ^{6N 14E} T. R.			
<u>4</u> miles <u>West</u> , of <u>Meridian</u> (distance) (direction) (Nearest Town)			
(3) Topography: <u>Hilly</u> (Hilly) (Flat) (Level)			
(4) Purpose of Well: <u>Home use</u> (Domestic Irrigation Municipal, Industrial, Other)	<u>Meridian</u>		


Information upon completion of well:

- (1) Diameter 4 1/2 inches.
- (2) Total Depth 238 feet.
- (3) Water Level 70 feet below top of ground.
- (4) Cased to 126, Size _____.
- (5) Screen: Size _____, Length _____.
- (6) Were any formations sealed against pollution?
_____ yes, _____ no.

If YES depth of formation _____

Why _____

Drillers Remarks: _____

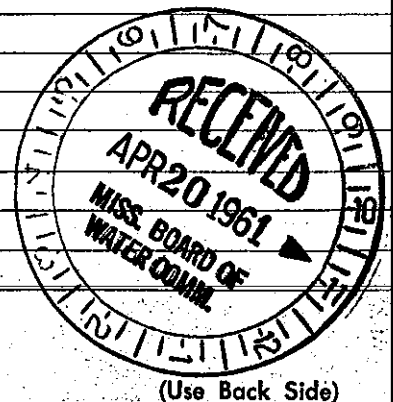

Well No.