

OF WATER COMMISSIONERS

WATER WELL DRILLERS LOG

LAUD.  
#4 L17

12-26-61

Date 12, 26, 1961, Driller McDONALD HILL County LAUDERDALE

(Name)


(1) Owner of Land: S. A. CASTLE  
(Name)  
MERIDIAN R# 5  
(Address)  
(2) Location: 6 miles WEST of MERIDIAN  
(distance) (direction) (Nearest Town)  
(3) Topography: X  
(Hilly) (Flat) (Level)  
(4) Purpose of Well: DOMESTIC  
(Domestic Irrigation, Municipal, Industrial, Other)

Description & Color of Materials Sand, Clay, Red Clay, Shell, etc.	Thick- ness Feet	Depth Feet
<u>CLAY</u>	<u>0</u>	<u>20</u>
<u>SAND CLAY</u>	<u>20</u>	<u>35</u>
<u>SHALE at Sand</u>	<u>35</u>	<u>105</u>
<u>SHALE</u>	<u>105</u>	<u>174</u>
<u>SANDY SHALE</u>	<u>174</u>	<u>195</u>
<u>SHALE</u>	<u>195</u>	<u>280</u>
<u>SAND</u>	<u>280</u>	<u>310</u>
<u>SANDY SHALE</u>	<u>310</u>	<u>350</u>

Information upon completion of well:

- (1) Diameter 3" inches.  
 (2) Total Depth 350' feet.  
 (3) Water Level 38' feet below top of ground.  
 (4) Cased to 126', Size 3"  
 (5) Screen: Size \_\_\_\_\_, Length \_\_\_\_\_  
 (6) Were any formations sealed against pollution?  
 \_\_\_\_\_ yes, \_\_\_\_\_ no.

If YES depth of formation \_\_\_\_\_  
 Why \_\_\_\_\_  
 Drillers Remarks: \_\_\_\_\_

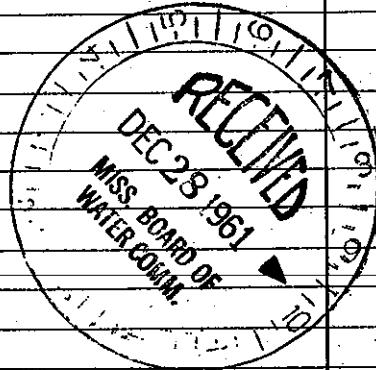

W