

LAUD. MISSISSIPPI BOARD OF WATER COMMISSIONERS

AL 18  
5-17-62

WATER WELL DRILLERS LOG

Date: 5-17, 1962, Driller: McDonald & H.M. County Lauderdale  
(Name)



(1) Owner of Land: Billy Hughes  
(Name)  
Rt #5, meridional  
(Address)  
(2) Location: 1/4, 1/4, Sec. 23, T. R.  
5 miles West of meridional  
(distance) (direction) (Nearest Town)  
(3) Topography:  (Hilly)  (Flat)  (Level)  
(4) Purpose of Well: Domestic  
(Domestic Irrigation, Municipal, Industrial, Other)

Description & Color of Materials Sand, Clay, Red Clay, Shell, etc.	Thick- ness Feet	Depth Feet
Rock st. Clay	0	10
Soft Rock st. Shale	10	40
Shale	40	85
Sand	85	112
Shale	112	185
Sand	185	201

Information upon completion of well:

(1) Diameter 2 inches.  
(2) Total Depth 201 feet.  
(3) Water Level 116' feet below top of ground.  
(4) Cased to 200', Size 2  
(5) Screen: Size 2", Length 4'  
(6) Were any formations sealed against pollution?  
yes,  no.

If YES depth of formation  
Why  
Drillers Remarks:

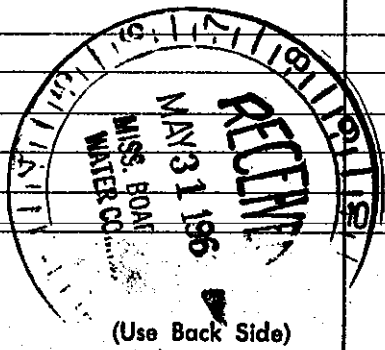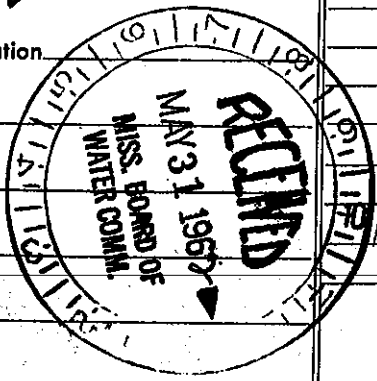

Well No.