

LAUD.

MISSISSIPPI BOARD OF WATER COMMISSIONERS

M L 20  
6-27-63

WATER WELL DRILLERS LOG

McDONALD & HILL, Inc.

Date: 6.27, 1963, Driller: P. O. Box 21 County

Meridian, Miss.

(1) Owner of Land: CLIFF HARBOR  
(Name)  
R#5 MERIDIAN  
(Address) 6 N 14E

(2) Location: 1/4, 1/4, Sec. 23 T. R.  
5 miles WEST of MERIDIAN  
(distance) (direction) (Nearest Town)

(3) Topography: X  
(Hilly) (Flat) (Level)

(4) Purpose of Well: DOMESTIC  
(Domestic Irrigation  
Municipal, Industrial, Other)

Description & Color of Materials Sand, Clay, Red Clay, Shell, etc.	Thick- ness Feet	Depth Feet
CLAY	0	18
SHALE	18	60
FINE SAND	60	85
SHALE	85	102
ROCK	102	105
SOFT SHALE	105	140
SAND	140	164
SHALE	164	185
SAND	185	195

Information upon completion of well:

(1) Diameter 4" inches.


(2) Total Depth 200' feet.

(3) Water Level 68' feet below top of ground.

(4) Cased to 98', Size 4"

(5) Screen: Size \_\_\_\_\_, Length \_\_\_\_\_

(6) Were any formations sealed against pollution?  
\_\_\_\_\_yes, \_\_\_\_\_no.

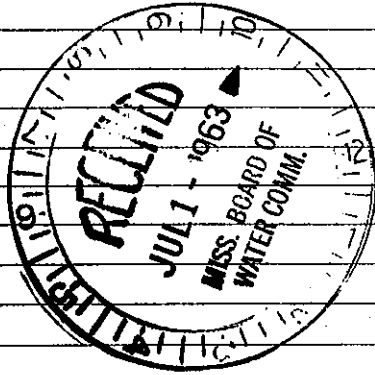

If YES depth of formation \_\_\_\_\_

Why \_\_\_\_\_

Drillers Remarks: \_\_\_\_\_

(Use Back Side)

Well No.