

LAUD.
 # L21
 7-3-63

WATER WELL DRILLERS LOG

Date: 7-3-63, 1963, Driller: JAMES MITCHELL County: Madison
(Name)

(1) Owner of Land:	Description & Color of Materials Sand, Clay, Red Clay, Shell, etc.	Thick- ness Feet	Depth Feet
<u>George CARPENTER</u> <small>(Name)</small>	<u>CLAY</u>	<u>0</u>	<u>20</u>
<u>R#5 MERIDIAN</u> <small>(Address)</small>	<u>SANDY CLAY</u>	<u>20</u>	<u>110</u>
Location: <u>6 N 1/4 E</u> _____ <u>23</u> T <u>R</u>	<u>SHALE</u>	<u>110</u>	<u>152</u>
<u>5</u> miles <u>WEST</u> of <u>MERIDIAN</u> <small>(distance) (direction) (Nearest Town)</small>	<u>ROCK</u>	<u>152</u>	<u>155</u>
(3) Topography: <u>X</u> <small>(Hilly) (Flat) (Level)</small>	<u>SANDY SHALE</u>	<u>155</u>	<u>195</u>
(4) Purpose of Well: <u>DOMESTIC</u> <small>(Domestic Irrigation Municipal, Industrial, Other)</small>			


Information upon completion of well:

- (1) Diameter 3 1/4 inches.
- (2) Total Depth 195' feet.
- (3) Water Level 84" feet below top of ground.
- (4) Cased to 126', Size 2"
- (5) Screen: Size _____, Length _____
- (6) Were any formations sealed against pollution?
 _____ yes, _____ no.

If YES depth of formation _____

Why _____

Drillers Remarks: _____

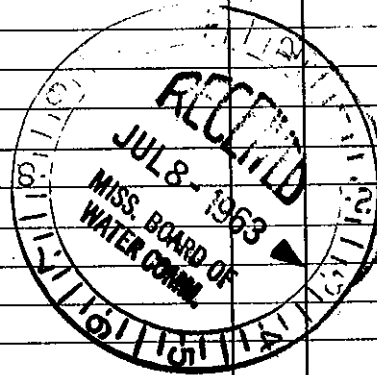

(Use Back Side)

Well No. _____

Mail this copy to Board of Water Commissioners 429 Miss. St. Jackson, Miss.