


LAUD. MISSISSIPPI BOARD OF WATER COMMISSIONERS

ML22
7-30-63

WATER WELL DRILLERS LOG

Date: 7.30, 1963, Driller: Mc Donald & Sons County _____
(Name)

(1) Owner of Land: <u>C. L. CLAYTON</u> (Name)	Description & Color of Materials Sand, Clay, Red Clay, Shell, etc.	Thick- ness feet	Depth Feet
<u>R#5 MERIDIAN</u> (Address)	<u>CLAY</u>	<u>8</u>	<u>8</u>
	<u>SAND</u>	<u>8</u>	<u>30</u>
(2) Location: <u>1/4, 1/4, Sec. 23</u> ^{ON NE} T. R.	<u>SANDY</u>	<u>30</u>	<u>90</u>
<u>4</u> miles <u>WEST</u> , of <u>MERIDIAN</u> , (distance) (direction) (Nearest Town)	<u>SHALE</u>	<u>90</u>	<u>365</u>
	<u>SAND</u>	<u>365</u>	<u>400</u>
(3) Topography: <u>X</u> (Hilly) (Flat) (Level)			
(4) Purpose of Well: <u>DOMESTIC</u> (Domestic Irrigation Municipal, Industrial, Other)			
Information upon completion of well:			
(1) Diameter <u>3 3/4</u> inches. <u>TEST HOLE</u>			
(2) Total Depth <u>400'</u> feet.			
(3) Water Level <u>10'</u> feet below top of ground.			
(4) Cased to <u>120'</u> , Size <u>4"</u>			
(5) Screen: Size _____, Length _____			
(6) Were any formations sealed against pollution? _____ yes, _____ no.			
If YES depth of formation _____			
Why _____			
Drillers Remarks: _____			

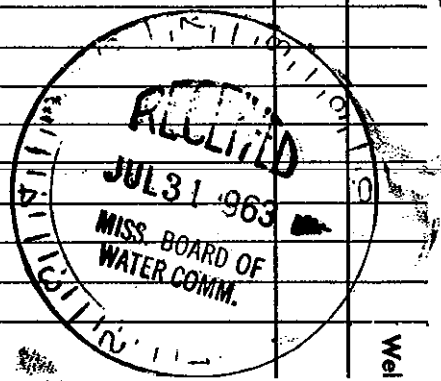

Well