

LAUD. MISSISSIPPI BOARD OF WATER COMMISSIONERS

ML23
10-4-63

WATER WELL DRILLERS LOG

21645

Date: 10-4, 1963, Driller: Mr. Donald L. Hill County Lauderdale
(Name)

(1) Owner of Land C. B. Burwell
(Name)
Rt. # 5, Meridian
(Address)

(2) Location: 1/4, 1/4, Sec. 23 T. 6N R. 14E
5 miles west, of Meridian
(distance) (direction) (Nearest Town)

(3) Topography: Hilly
(Hilly) (Flat) (Level)

(4) Purpose of Well: Domestic
(Domestic Irrigation
Municipal, Industrial, Other)

Description & Color of Materials Sand, Clay, Red Clay, Shell, etc.	Thick- ness Feet	Depth Feet
Sand	8	18
Sandy clay	18	30
Sand & gravel	30	42
Sandy clay	42	55
Sand w/ clay streaks	55	70
Shale	70	110
Brown sand	110	143
Shale & lign.	143	155
Shale	155	175
Sand w/ shale streaks	175	185
Sand	185	198
Shale w/ sand streaks	198	210
Sandy shale	210	225
Shale	225	237
Thin sand & shaleshale	237	290
Shale w/ some lign.	290	350
Shale	350	423
Hard lime	423	424
Sand & clay shale	424	437
Shale	437	470
Sandy shale	470	480

Information upon completion of well:

(1) Diameter 3 1/4 inches.

(2) Total Depth 480 feet.

(3) Water Level 150 feet below top of ground.

(4) Cased to 311, Size 4"


(5) Screen: Size _____, Length _____

(6) Were any formations sealed against pollution?
_____ yes, _____ no.

If YES depth of formation _____

Why _____

Drillers Remarks: _____

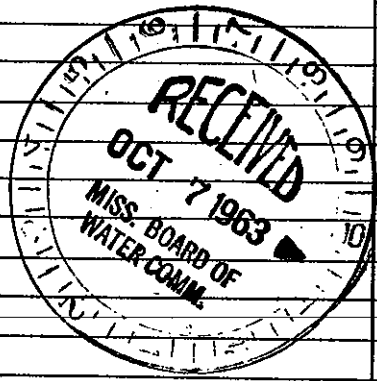

Well 115