

LAUD.
L24
7-11-64

WATER WELL DRILLERS LOG

Date: 7.11, 1964, Driller: M. E. Donald & H. H. Inc County: _____

(Name)

(1) Owner of Land: HARVEY PITTMAN
(Name)

R#5 MERIDIAN
(Address)

(2) Location: 1/4, 1/4, Sec 23 6N 16E T. R.

5 miles west of Meridian
(distance) (direction) (Nearest Town)

(3) Topography: ☒ (Hilly) ☐ (Flat) ☐ (Level)

(4) Purpose of Well: _____
(Domestic Irrigation
Municipal, Industrial, Other)

Information upon completion of well:

(1) Diameter 3 1/4 inches.

(2) Total Depth 160' feet.

(3) Water Level 52' feet below top of ground.

(4) Cased to 84', Size 2"

(5) Screen: Size _____, Length _____

(6) Were any formations sealed against pollution?

_____ yes, _____ no.

If YES depth of formation _____

Why _____

Drillers Remarks: _____

Description & Color of Materials
Sand, Clay, Red Clay, Shell, etc.

Thick-
ness
Feet

Depth
Feet

CLAY

0

14

YELLOW SAND

14

40

SANDY ST SHALE

40

70

SHALE

70

105

SANDY SHALE


105

140

FINE SAND

140

160

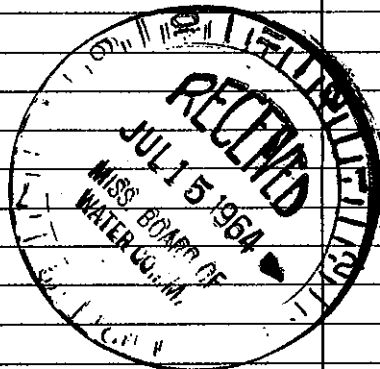

(Use Back Side)

Well No.

Mail this copy to Board of Water Commissioners 429 Miss. St. Jackson, Miss