

MISSISSIPPI BOARD OF WATER COMMISSIONERS

LAUD.
L39
9-20-60

WATER WELL DRILLERS LOG **CODED**

Date: 9.20, 1960, Driller: McDonald Bill County Lauderdale
(Name)

(1) Owner of Land: W. H. Hasson
(Name)
Rt 5 Meridian
(Address) 22 6 14
(2) Location: 1/4, 1/4, Sec. T R
6 miles West, of Meridian
(distance) (direction) (Nearest Town)
(3) Topography: _____
(Hilly) (Flat) (Level)
(4) Purpose of Well: Domestic
(Domestic Irrigation
Municipal, Industrial, Other)

Description & Color of Materials Sand, Clay, Red Clay, Shell, etc.	Thick- ness Feet	Depth Feet
<u>Clay</u>	<u>0</u>	<u>10</u>
<u>Sand</u>	<u>10</u>	<u>40</u>
<u>marl</u>	<u>30</u>	<u>140</u>
<u>sand</u>	<u>140</u>	<u>155</u>
<u>marl</u>	<u>155</u>	<u>188</u>
<u>fine sand</u>	<u>188</u>	<u>210</u>
<u>marl</u>	<u>210</u>	<u>260</u>
<u>sand</u>	<u>260</u>	<u>280</u>

Information upon completion of well:


- ① Diameter 4" inches.
② Total Depth 280" feet.
③ Water Level 44" feet below top of ground.
④ Cased to 280, Size 4" x 2"
⑤ Screen: Size 2, Length 5'
⑥ Were any formations sealed against pollution?
_____ yes, X no.

If YES depth of formation _____

Why _____

Drillers Remarks: _____

CODED

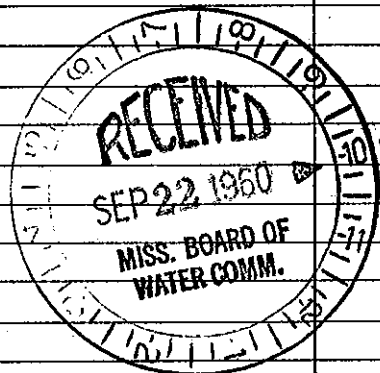

Well No.

(Use Back Side)

Mail this copy to Board of Water Commissioners 429 Miss. St. Jackson, Miss.