

LAUD. MISSISSIPPI BOARD OF WATER COMMISSIONERS

L 40
10-11-60

WATER WELL DRILLERS

CODED

300
L 1

Date: 10-11-60 19___, Driller: McDonald, Bill County: Lauderdale
(Name)


(1) Owner of Land: James Boutwell
(Name)
Mechan Miss
(Address)
(2) Location: 1/4, 2 1/4, Sec. 6 1/4 T. R.
10 miles West, of Mendenhall
(distance) (direction) (Nearest Town)
(3) Topography: X
(Hilly) (Flat) (Level)
(4) Purpose of Well: Domestic
(Domestic Irrigation
Municipal, Industrial, Other)

Description & Color of Materials Sand, Clay, Red Clay, Shell, etc.	Thick- ness Feet	Depth Feet
Clay	0	10
Rock	10	12
Clay	12	18
Rock	18	32
Marl	32	90
Soft marl	90	115
Soft sandy marl	115	165
Sandy shale	165	205
Sand	205	218
Marl	218	260
Sand	260	280

Information upon completion of well:

(1) Diameter: 4" inches.
(2) Total Depth: 280' feet.
(3) Water Level: 42' feet below top of ground.
(4) Cased to: 231', Size: 4"
(5) Screen: Size _____, Length _____
(6) Were any formations sealed against pollution?
_____ yes, X no.
If YES depth of formation _____
Why _____
Drillers Remarks: _____

CODED

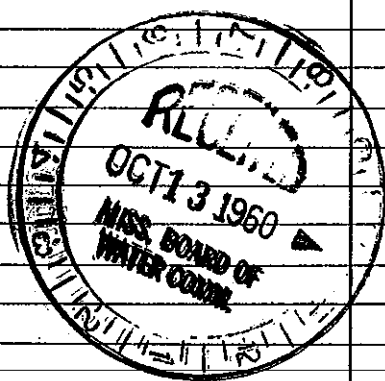

Well No.

(Use Back Side)

Mail this copy to Board of Water Commissioners 429 Miss. St. Jackson,