

MISSISSIPPI BOARD OF WATER COMMISSIONERS

LAUO.
L 41
12-7-62

WATER WELL DRILLERS LOG

CODED

Date: 12-7, 1962, Driller: McDONALD & HILL, Inc County: Lauderdale
P. O. (Box #) 81


(1) Owner of Land: Rev. E.D. Gemeny
(Name)
Chucky Miss.
(Address)
30 67
(2) Location: 1/4, 30 67 Sec. 67 R
12 miles W of Meriden
(distance) (direction) (Nearest Town)
(3) Topography: (Hilly) (Flat) (Level)
(4) Purpose of Well: Domestic
(Domestic Irrigation
Municipal, Industrial, Other)

Description & Color of Materials Sand, Clay, Red Clay, Shell, etc.	Thick- ness Feet	Depth Feet
<u>Sand - sandy clay</u>	<u>0</u>	<u>23</u>
<u>Shiny shale</u>	<u>23</u>	<u>119</u>
<u>pland</u>	<u>119</u>	<u>150</u>

CODED

Information upon completion of well:

(1) Diameter 4 inches.
(2) Total Depth 150 feet.
(3) Water Level 33 feet below top of ground.
(4) Cased to 42, Size 4
(5) Screen: Size ✓, Length _____
(6) Were any formations sealed against pollution?
_____ yes, ✓ no.
If YES, depth of formation _____
Why _____
Drillers Remarks: _____

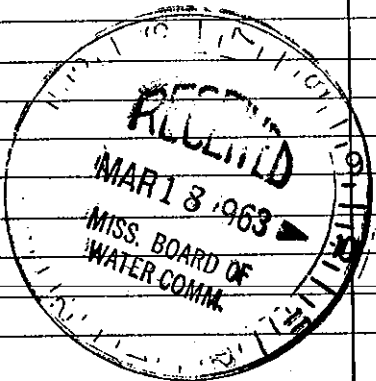

Well No.

(Use Back Side)