

L 42

WATER WELL DRILLERS LOG

CODED

8-27-63

Date: 8-27, 1963, Driller: me Donald & Hill County Landdale
(Name)


(1) Owner of Land: Ed Sowell
(Name)
PT 5
(Address)
24614
(2) Location: 1/4, 1/4 Sec. T. R.
4 miles of Meridian
(distance) (direction) (Nearest Town)
(3) Topography: Hilly
(Hilly) (Flat) (Level)
(4) Purpose of Well: Domestic
(Domestic Irrigation
Municipal, Industrial, Other)

Description & Color of Materials Sand, Clay, Red Clay, Shell, etc.	Thick- ness Feet	Depth Feet
Clay	0	16
Shale	16	30
Shale	30	33
Silty shale	33	42
Shale	42	87
Hard lime rock	87	88
Silty sh. shale	88	93
Shale	93	102
Silty shale	102	118
Shale	118	168
Hard lime rock	168	169
Shale	169	177
Sandstone	177	179
Shale	179	190
Silty shale	190	199
Shale	199	208
Silty shale & sil	208	211
Shale	211	229
Silty shale	229	240
Fine sand	240	268

Information upon completion of well:

(1) Diameter 3 7/8 inches.
(2) Total Depth 268 feet.
(3) Water Level 0'0" feet below top of ground.
(4) Cased to 124, Size 4
(5) Screen: Size _____, Length _____
(6) Were any formations sealed against pollution?
_____ yes, _____ no.

CODED

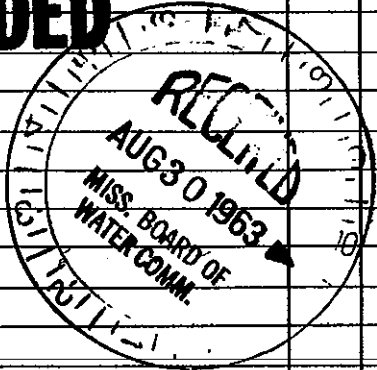

If YES depth of formation _____
Why _____
Drillers Remarks: _____

Well No.
1021

(Use Back Side)