

LAUD.  
L 43  
9-10-64

WATER WELL DRILLERS LOG

**CODED**


Date: 7-10, 1964, Driller: M<sup>r</sup> Donald d Hill, Jr, County Lauderdale  
(Name)

(1) Owner of Land	Description & Color of Materials Sand, Clay, Red Clay, Shell, etc.	Thick- ness Feet	Depth Feet
<u>MRS MATTIE STARNES</u> (Name)	<u>CLAY</u>	<u>0</u>	<u>15</u>
<u>MEEHAN MISS</u> (Address)	<u>SHALE ST ROCK</u>	<u>15</u>	<u>50</u>
(2) Location: <u>1/4, 2, 614</u> T R	<u>SHALE</u>	<u>50</u>	<u>65</u>
<u>8</u> miles <u>East</u> , of <u>Meridian</u> (distance) (direction) (Nearest Town)	<u>SAND</u>	<u>65</u>	<u>84</u>
(3) Topography: <u>X</u> (Hilly) (Flat) (Level)	<u>SHALE</u>	<u>84</u>	<u>130</u>
(4) Purpose of Well: <u>DOMESTIC</u> (Domestic Irrigation Municipal, Industrial, Other)	<u>SHALE ST SAND</u>	<u>130</u>	<u>158</u>
	<u>SOFT SHALE</u>	<u>158</u>	<u>185</u>
	<u>SANDY</u>	<u>185</u>	<u>200</u>

Information upon completion of well:

- (1) Diameter 3 1/2 inches. TEST HOLE
- (2) Total Depth 200' feet.
- (3) Water Level 54' feet below top of ground.
- (4) Cased to 97', Size 4"
- (5) Screen: Size \_\_\_\_\_, Length \_\_\_\_\_
- (6) Were any formations sealed against pollution?  
\_\_\_\_\_ yes, \_\_\_\_\_ no.

**CODED**

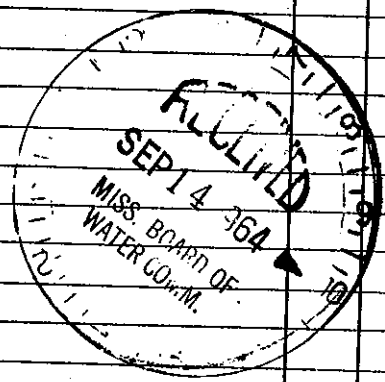

If YES depth of formation \_\_\_\_\_  
Why \_\_\_\_\_  
Drillers Remarks: \_\_\_\_\_

Well No.

(Use Back Side)