

STATE WELL REPORT

Part 1

Driller's Log

Mississippi Department of Environmental Quality
Office of Land and Water Resources
P.O. Box 2309
Jackson, MS 39225-2309
(601)961-5210
(601)360-0535 (fax)

For Office Use Only:

Well #: L 11
Aquifer: _____
E-Log #: _____

County: Lauderdale
Permit #: _____
Driller: McDonald + Hill
Date drilling completed: 11-10-15

State Law requires that this report be prepared by the license holder responsible for the work and filed with the Department at the above address within 30 days of completion of drilling of the well or borehole.

<p style="text-align: center;">Well Owner Information (Landowner if borehole is not for a water well)</p> <p>Owner Name: <u> Hattiesburg Home Center </u> Mailing Address: <u> PO Box 5989 </u> <u> Brandon </u> <u> MS </u> City State Zip Code Telephone No. (____) _____</p>	<p style="text-align: center;">Well or Borehole Location</p> <p>Latitude: <u> 32.335839 </u> Longitude: <u> -88.888295 </u> Method of Lat/Long (check one): Conventional Survey _____ USGS quad _____, Hand-held GPS _____, Survey-grade GPS _____ <u> SW 1/4 NE 1/4, Sec 29 T 6N R 14E </u> ____ Miles of _____ (Distance) (Direction) (Nearest Town)</p>
--	---

Well / Borehole Data
Date drilling started: <u> 11-5-15 </u> Date drilling completed: <u> 11-10-15 </u> Hole depth: <u> 390' </u> Hole diameter: <u> 4 1/2" </u>
Location of the source of any surface water used for drilling: <u> Community water </u>
Method of dosing and volume of Chlorine used in drilling and development: _____
Logs run (circle all applicable): <input checked="" type="checkbox"/> No log run <input type="checkbox"/> Electric <input type="checkbox"/> Gamma Ray <input type="checkbox"/> Density <input type="checkbox"/> Sonic <input type="checkbox"/> Neutron <input type="checkbox"/> Other: _____
Name of organization running log(s): _____
Purpose of borehole (circle one): <input checked="" type="checkbox"/> Water Well <input type="checkbox"/> Geotechnical/Geological Investigation <input type="checkbox"/> Ground Source Heat Pump <input type="checkbox"/> Seismic Survey <input type="checkbox"/> Other (describe) _____
<i>If drilling is not related to water well construction, skip the remainder of this block</i>
Purpose of Well (circle all applicable): <input checked="" type="checkbox"/> Home <input type="checkbox"/> Industrial <input type="checkbox"/> Public Supply <input type="checkbox"/> Irrigation <input type="checkbox"/> Fish Culture
Other (describe): _____
If a flowing well, method of flow regulation: Valve _____ Other (describe) _____
Static Water Level: <u> 170 </u> feet [above or <input checked="" type="checkbox"/> below] and surface Date measured: <u> 11-10-15 </u> (circle one)
Method of measurement (circle one): <input checked="" type="checkbox"/> Steel tape <input type="checkbox"/> Electric tape <input type="checkbox"/> Air line <input type="checkbox"/> Other (describe): _____
Well depth: <u> 390 </u> Well grouted to a depth of: <u> 10 </u> feet Type of grout (circle one): Neat Cement <input checked="" type="checkbox"/> Bentonite <input type="checkbox"/> Mix
Casing length: <u> 370 </u> feet Casing diameter: <u> 4 </u> inches Type of casing: <u> PVC </u>
Screen length: <u> 20 </u> feet Screen diameter: <u> 4 </u> inches Type of screen: <u> PVC sanded </u>
Screen slot size: <u> .010 </u> inches Setting depth: From <u> 370 </u> feet to <u> 390 </u> feet
Type of completion (circle all applicable): Gravel packed <input type="checkbox"/> Underreamed <input type="checkbox"/> Open hole <input type="checkbox"/> Natural Development <input type="checkbox"/>
Other (describe): <u> SAND PACKED </u>
Top of lap pipe or reduction in casing: _____ feet
<i>If telescoped or more than one screen, describe on next page</i>

Received


JUN 27 2016

By OLWR

County: _____
 Permit #: _____

For Office Use Only:
 Well #: 111

The sketch below only required for water wells
If well telescopes, show depths on sketch.

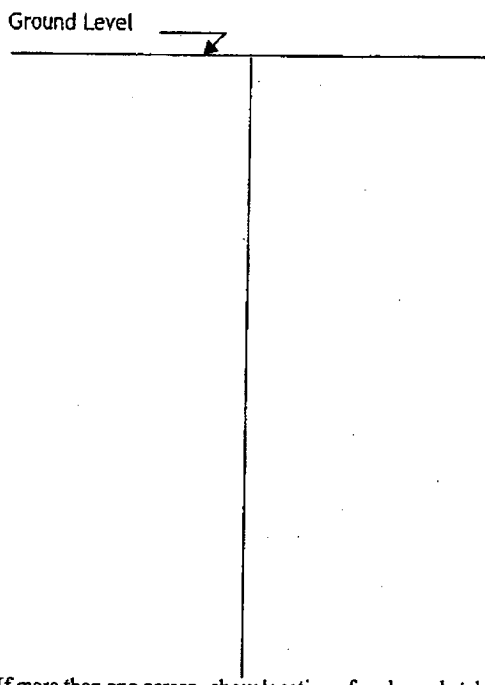

Description of formations encountered must be provided for all wells and boreholes, unless specifically exempted by regulations

Description of Formations Encountered	From (depth)	To (depth)
Red Sandy clay	Ground level	10
Rock	10	12
white clay	12	20
shale Rock st.	20	140
Sandy shale	140	160
fine sand	160	180
Medium sand	180	210
Coarse sand	210	220
Medium sand	220	230
Sandy shale	230	235
shale	235	250
Sandy shale	250	260
shale	260	300
sand	300	310
Fine sand - shalest.	310	300
Good sand.	360	387
shale.	300 367	

If more than one screen, show location of each on sketch

Sketch the property layout and include the following:

- 1) the well location
- 2) any permanent structures on the property that may aid in locating the well
- 3) any roads, power lines, or other items that may aid in locating the property and the well
- 4) north arrow

Received

JUN 27 2016

By OLWR

Landowner Name: Hattiesburg Home Center

I HEREBY CERTIFY that the well/borehole was drilled, constructed, and completed in accordance with all applicable requirements of the Mississippi Department of Environmental Quality and the Mississippi Department of Health regulations, if applicable, and state laws.

Harold Hill McDonald Hill #08 6-24-16 Harold Hill

Print Name of Responsible Licensee and License No. Date Signature of Licensee

STATE WELL REPORT

Part 2

Pump Installer's Completion Report
 Mississippi Department of Environmental Quality
 Office of Land and Water Resources
 P.O. Box 2309
 Jackson, MS 39225-2309
 (601)961-5210
 (601) 360-0535 (fax)

County: Lauderdale
 Permit #: _____
 Driller: McDonald + Hill
 Date completed: 11-11-15
Copy information from block on Part 1

For Office Use Only:

Well #: LN1
 Aquifer: _____

This part of the report must be completed by a licensed water well contractor or a licensed pump installer. A copy of Part 1 of the report must be attached and both parts filed with the Department at the above address within 30 days of well completion.

Well Owner Information	Well Location
Owner Name: <u>Hattiesburg Home Center</u>	Latitude: <u>32.335839</u> Longitude: <u>-88.888295</u>
Mailing Address: <u>PO Box 5989</u>	Method of Lat/Long (check one): Conventional Survey _____, USGS quad _____, Hand-held GPS _____, Survey-grade GPS _____
<u>Brandon</u> MS Zip Code _____	_____ 1/4 _____ 1/4, Sec <u>29</u> T <u>6N</u> R <u>14E</u>
City State Zip Code	_____ Miles _____ of _____ (Distance) (Direction) (Nearest Town)
Telephone No. () _____	

Pump Type (circle one)

Submersible Turbine Air Lift Centrifugal Flowing Well Jet Piston Rotary Other (describe): _____

Date Pump Installed: 11-11-15 Rated Pump Capacity: 5 Gallons Per Minute

Is This Pump (circle one): New Repaired Replacement

Power Type (circle one)

Electric Diesel Gasoline Natural Gas Tractor PTO Windmill Other (describe): _____

Horse Power Rating of Motor: 1/2 Setting Depth: 160 feet Number of Stages: _____

Pump Test Data for Non Flowing Well

Date Well Tested: 11-11-15 Duration of Pump Test (minimum 4 hours): 4 hours

Static Water Level (A): 120 Feet Below Land Surface Pumping Water Level (B): 140 Feet Below Land Surface

Drawdown [(B) - (A)]: 20 Feet Below Land Surface Test Pumping Rate: 5 Gallons Per Minute

Method of measurement (circle one): Steel tape Electric tape Air line Other (describe): _____

Pump Test Data for Flowing Well

Measured shut in head: _____ feet.

Well yielded 5 GPM with a drawdown of 20 feet after 4 hours of pumping

Meter Installation

Meter Manufacturer: _____ Meter Serial Number: _____

Meter Model Number/Name: _____ Type of Meter: _____

Totalizer Register Unit and Multiplier Factor (AF x .001, gal x 1000, etc): _____

Installation Date: _____ Meter installed by: _____

Is This Meter (circle one): New Repaired Replacement

Received
JUN 27 2016
By OLWR

Important: By submitting the above information you are certifying that this meter was installed to manufacturer standards. For agricultural wells, a list of approved meters is on the MDEQ website.

I HEREBY CERTIFY that the above statements are true to the best of my knowledge.

Harold Hill McDonald + Hill #08 6-24-16 Harold Hill
 Print Name of Pump Installer and License No. (if applicable) Date Signature of Pump Installer