

MISSISSIPPI BOARD OF WATER COMMISSIONERS

WATER WELL DRILLERS LOG

Date: 7-7-60, 1960, Driller: Harter Ogletree County Wichita
 (Name)

	Description & Color of Materials Sand, Clay, Red Clay, Shell, etc.	Thick- ness Feet	Depth Feet
(1) Owner of Land: <u>Lucian Sumner</u> (Name) <u>Rt. 5 Meridian Miss</u> (Address)	<u>Blue clay</u>		
(2) Location: <u>1/4, 1/4, Sec. T R</u> <u>3 miles north of Meridian</u> (distance) (direction) (Nearest Town)			
(3) Topography: <u>Flat</u> (Hilly) (Flat) (Level)			
(4) Purpose of Well: <u>Home use</u> (Domestic Irrigation Municipal, Industrial, Other)			


Information upon completion of well:

- (1) Diameter 4 1/2 inches.
- (2) Total Depth 132 feet.
- (3) Water Level 32 ft feet below top of ground.
- (4) Cased to 84, Size 2"
- (5) Screen: Size _____, Length _____.
- (6) Were any formations sealed against pollution?
 yes, no.

If YES depth of formation _____

Why _____

Drillers Remarks: _____

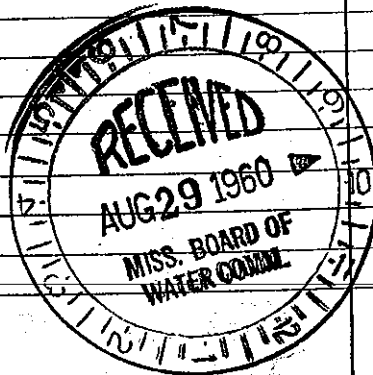

(Use Back Side)

his copy to Board of Water Commissioners 429 Miss. St. Jackson