

LAUD.

M9

7-14-64

WATER WELL DRILLERS LOG

16

Date: 7-14, 1964, Driller: Bob Williams County Lauderdale (Name)

(1) Owner of Land: Doyle Joyner (Name) Rt. 2 Meridian (Address)

(2) Location: SE 1/4, SW 1/4, Sec. 4 T. 6 R. 15, 4 miles N.W. of Meridian (distance) (direction) (Nearest Town)

(3) Topography: Hilly (Hilly) (Flat) (Level)

(4) Purpose of Well: Domestic (Domestic Irrigation Municipal, Industrial, Other)

Description & Color of Materials Sand, Clay, Red Clay, Shell, etc.	Thick-ness Feet	Depth Feet
Blue Clay	30	1-30
gray sand	35	30-63
Blue clay	35	65-100
white sand	50	100-150
Blue Clay		


Information upon completion of well:

- (1) Diameter: 4 inches.
- (2) Total Depth: 275 feet.
- (3) Water Level: 52 feet below top of ground.
- (4) Cased to: 80, Size: 4"
- (5) Screen: Size: 0, Length:
- (6) Were any formations sealed against pollution? yes, no.

If YES depth of formation: surface water.

Why:

Drillers Remarks:

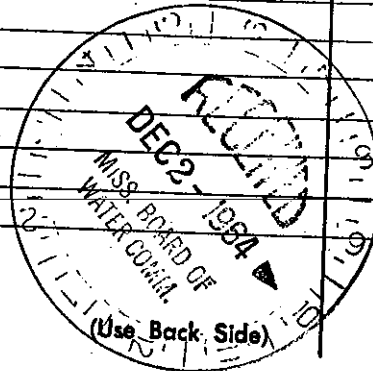

Well No.

Retain this copy for your office files.