

LAUD.

MISSISSIPPI BOARD OF WATER COMMISSIONERS

M 10

WATER WELL DRILLERS LOG

~~1300~~

9-7-60

Date: 9-7, 1960, Driller: Peoples of Rutledge County, Lauderdale

(Name)

(1) Owner of Land: To be sold.

(Name)

Bosby - Contractor -

(Address)

(2) Location: 1/4, 1/4, Sec 16 T8R15E

3 miles North West of Meridian

(distance) (direction) (Nearest Town)

(3) Topography: Hilly

(Hilly) (Flat) (Level)

(4) Purpose of Well: Domestic

(Domestic Irrigation  
Municipal, Industrial, Other)

Description & Color of Materials Sand, Clay, Red Clay, Shell, etc.	Thick- ness Feet	Depth Feet
Yellow Sandy Clay	15	15
Marl & Micaite	58	73
Sandy Shale	11	84
Hard Small Shale Plus	24	108
Soft Sandy Shale	10	118
Hard Shale	84	199
Hard Shaled Sand Plus	210	409


Information upon completion of well:

- (1) Diameter: 4 inches.
- (2) Total Depth: 409 feet.
- (3) Water Level: 80' feet below top of ground.
- (4) Cased to 106, Size 4"
- (5) Screen: Size \_\_\_\_\_, Length \_\_\_\_\_.
- (6) Were any formations sealed against pollution?  
\_\_\_\_\_ yes, \_\_\_\_\_ no.

If YES depth of formation \_\_\_\_\_

Why \_\_\_\_\_

Drillers Remarks: \_\_\_\_\_

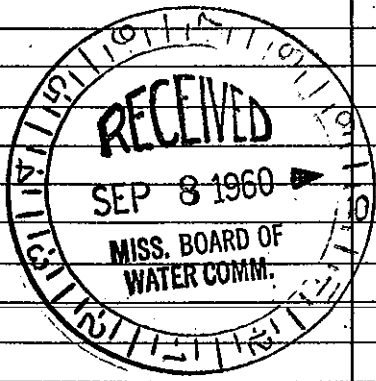

Well