


LAUG
M 11
3-62

MISSISSIPPI BOARD OF WATER COMMISSIONERS

WATER WELL DRILLERS LOG

Date: March, 1962, Driller: Peeples & R. Millidge County, Paucedale
(Name)

(1) Owner of Land: <u>Tommy Lee Henson</u> (Name)	Description & Color of Materials Sand, Clay, Red Clay, Shell, etc.	Thick- ness Feet	Depth Feet
<u>Rt. 5 Meridian, Miss</u> (Address)	<u>Top soil to yellow clay</u>	<u>12</u>	<u>12</u>
(2) Location: <u>SE 1/4, NW 1/4, Sec. 16 T6N R15E</u> <u>Lakewood Sub-Division</u>	<u>Blue marl with small</u>		
<u>2</u> miles <u>West</u> , of <u>Meridian</u> (distance) (direction) (Nearest Town)	<u>black lignite streaks</u>	<u>34</u>	<u>46</u>
(3) Topography: <u>Hilly</u> (Hilly) (Flat) (Level)	<u>Yellow sand & sandy</u>		
(4) Purpose of Well: <u>Domestic</u> (Domestic Irrigation Municipal, Industrial, Other)	<u>clay streaks</u>	<u>23</u>	<u>69</u>
Information upon completion of well:	<u>Gray sandy shale</u>	<u>39</u>	<u>108</u>
(1) Diameter: <u>4</u> inches.	<u>Rock</u>	<u>2</u>	<u>110</u>
(2) Total Depth: <u>300</u> feet.	<u>Gray sandy shale</u>	<u>44</u>	<u>154</u>
(3) Water Level: <u>48</u> feet below top of ground.	<u>Rock</u>	<u>3</u>	<u>157</u>
(4) Cased to: <u>84'</u> , Size <u>4"</u>	<u>Gray shale</u>	<u>15</u>	<u>172</u>
(5) Screen: Size <u>None</u> , Length _____	<u>Gray sand</u>	<u>6</u>	<u>178</u>
(6) Were any formations sealed against pollution? <input checked="" type="checkbox"/> yes, <input type="checkbox"/> no.	<u>Gray sandy shale</u>	<u>19</u>	<u>197</u>
If YES depth of formation <u>69'</u>	<u>Black lignite</u>	<u>2</u>	<u>199</u>
Why <u>High iron content</u>	<u>Gray sandy shale &</u>		
Drillers Remarks: _____	<u>sand streaks</u>	<u>84</u>	<u>283</u>
	<u>Gray sand + small</u>		
	<u>gray shale streaks</u>	<u>17</u>	<u>300</u>
	<u>Extremely Hard rock</u>	<u>?</u>	<u>301</u>

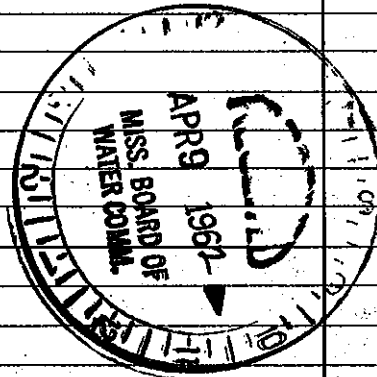

ME