

Lauderdale
M 15

8-66 MISSISSIPPI BOARD OF WATER COMMISSIONERS

WATER WELL DRILLERS LOG

Date: 8-18, 1966, Driller: M. E. Donald Hill County Lauderdale
(When well drilled) (Name) (Where well is located)


(1) Owner of Land: Gulf Oil Co
(Name)
17.45, Meridian, Miss.
(Address)
 (2) Location: 6 15 Sec. 30 T. 9 R. E.
on Highway 80
2 miles West of Meridian
(distance) (direction) (Nearest Town)
 (3) Topography: X
(Hilly) (Flat) (Level)
 (4) Purpose of Well: Service Station
(Domestic Irrigation Municipal, Industrial, Other)

Description & Color of Materials Sand, Clay, Red Clay, Shell, etc.	Thick- ness Feet	Depth Feet
Sand & Clay	0	84
Clay	84	90
Shale & Sand	90	112
Shale	112	118
fine sand	118	150
Shale	150	190
Sand & Shale	190	210
Shale	210	244
Rock	244	247
Shale	247	310
fine sand	310	320
Shale	320	350
fine sand	350	360
Shale	360	400
Sand	400	406
Shale	406	480
Sandy shale & Sand	480	502
Shale	502	530
fine sand	530	590

Information upon completion of well:

(1) Diameter 4" inches.
 (2) Total Depth 590' feet.
 (3) Water Level 130' feet below top of ground.
 (4) Cased to 275', Size 4"
 (5) Screen: Size None, Length _____
 (6) Were any formations sealed against pollution?
no.

If YES depth of formation _____
 Why _____
 Drillers Remarks: _____
 Yield in gpm: _____
 Size pump: _____
 Type power: _____

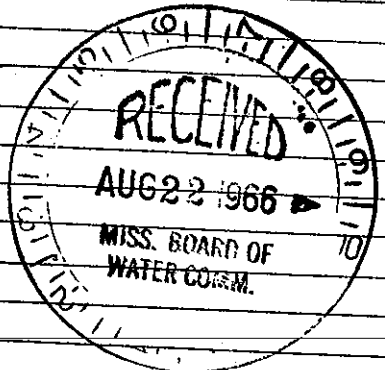

Retain this copy for your office files.