

LAUD. MISSISSIPPI BOARD

M19

9-25-63

WATER WELL DRILLERS LOG

Date: 9-25, 1963, Driller: Jerry, County: Laud

(1) Owner of Land: Colonial Pipe Line (Name)
Baton Rouge, La. (Address)

(2) Location: 1/4, 1/4, Sec. 20, T. 6N, R. 15E
1 miles W of MDN (direction) (Nearest Town)

(3) Topography: (Hilly) (Flat) (Level)

(4) Purpose of Well: Industrial (Domestic Irrigation, Municipal, Industrial, Other)

Description & Color of Materials Sand, Clay, Red Clay, Shell, etc.	Thick- ness Feet	Depth Feet
Yellow Clay	0	18
Sandy Shale	18	400
gummy dirt	400	550
Sandy	550	611

Information upon completion of well:


- (1) Diameter 4" inches.
- (2) Total Depth 611 feet.
- (3) Water Level 8' feet below top of ground.
- (4) Cased to 611', Size 4" X 2"
- (5) Screen: Size 2", Length 25'
- (6) Were any formations sealed against pollution?
yes, no.

If YES depth of formation 0-212

Why Soft & Sandy

Drillers Remarks: Well pumps

50 gpm 50 ft drawdown

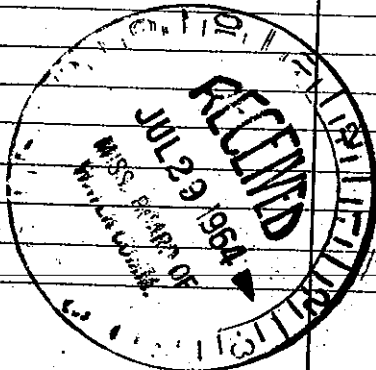

Well 1