

LAUD.

MISSISSIPPI BOARD OF WATER COMMISSIONERS

M23

12-1-64

WATER WELL DRILLERS LOG

Date: 12/1, 1964, Driller: TERRY, County LAUD

(1) Owner of Land: KROEHLER Mfg. Co  
(Name)  
MERIDIAN, Miss  
(Address)

(2) Location: 1/4, 1/4, Sec. T R  
1 miles W of MDN  
(distance) (direction) (Nearest Town)

(3) Topography:  (Hilly)  (Flat)  (Level)

(4) Purpose of Well: INDUSTRIAL  
(Domestic Irrigation, Municipal, Industrial, Other)

Description & Color of Materials Sand, Clay, Red Clay, Shell, etc.	Thick- ness Feet	Depth Feet
yellow clay	14	14
Coarse white sand	7	21
hard blue dirt	10	31
fine sand	70	101
blue dirt	150	250
Sandy	100	350
Grummy dirt	70	420
sandy streaks	100	520
shell streaks & sandy	160	680
Coarse sand	150	830

Information upon completion of well:


- (1) Diameter 16 inches.
- (2) Total Depth 832 feet.
- (3) Water Level 18' feet below top of ground.
- (4) Cased to 600, Size 16"
- (5) Screen: Size 14", Length 124'
- (6) Were any formations sealed against pollution?  
 yes,  no.

No. 2. well drilled  
300ft. North & well  
drilled same as this  
except 100' 10" screen  
used instead 14"

If YES depth of formation 600' CEMENT  
Why

Drillers Remarks: Well pumps  
2800 gpm -

No. 2. well pumps 3000  
gpm

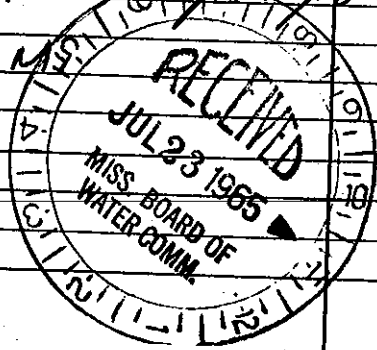

Well