

Lauderdale
M24 MISSISSIPPI BOARD OF WATER COMMISSIONERS

9-65

WATER WELL DRILLERS LOG

Date: Sept 25, 1965, Driller: Robert E. Raliff County Lauderdale
(Name)

(1) Owner of Land: Kroehler Mfg. Co.
(Name)
Meridian, Miss.
(Address)

(2) Location: 1/4, 1/4, Sec. T, R
1 miles town of Meridian
(distance) (direction) (Nearest Town)

(3) Topography: flat
(Hilly) (Flat) (Level)

(4) Purpose of Well: industrial
(Domestic Irrigation
Municipal, Industrial, Other)

Description & Color of Materials Sand, Clay, Red Clay, Shell, etc.	Thick- ness Feet	Depth Feet
<u>Mr. Norman Terry Terry Drilling Company has The drillers log; we were sub-contractors on this job.</u>		

This well was
under-reamed
30 inches and
a 10" screen
graveled in
place.


The 16" casing
was set and
cemented in
place, when
we moved
on the job.

Information upon completion of well:

- (1) Diameter 16 inches.
- (2) Total Depth 810 feet.
- (3) Water Level 22 feet below top of ground.
- (4) Cased to 500' 16" bal. 10", Size 16" X 10".
- (5) Screen: Size 10", Length 80".
- (6) Were any formations sealed against pollution?
Yes, no.

If YES depth of formation
Why 500' 16" casing cemented
in place

Drillers Remarks:
Mr. Roy Newcome with
the U. A. B. S. ran the
pumping test

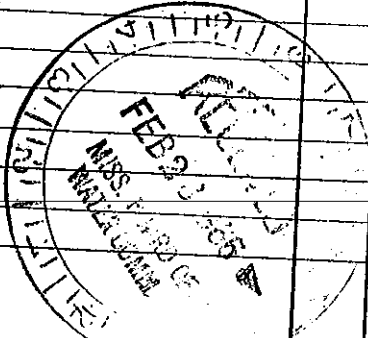

(Use Back Side)

Well No.

Mail this copy to Board of Water Commissioners 429 Miss. St. Jackson, Miss.