

MISSISSIPPI
BOARD OF WATER COMMISSIONERS
416 North State Street
Jackson, Mississippi 39201

WATER WELL DRILLERS LOG

LAUDERDALE
M 25
11-67
GW04158
11-1-

1967 Jerry Drilling Co. Land
date well completed firm name county well located


LANDOWNER:
Russell, Anconda
Miami Water Corp.
Meridian, Miss.
(mailing address)

WELL LOCATION:
sec. 23 T. 6 N R. 15 E
S W
1 miles W of Mdn
(distance) (direction) (nearest town)

WELL PURPOSE:
(home, irrigation, municipal, industrial)

WELL COMPLETION DATA:
(1) diameter (inches) 8"
(2) total depth (feet) 811'
(3) static water level (feet) 19' below top of ground.
(4) casing 6" (material) 513' (depth)
6" If telescope see back.
(5) screen 66' (length) 740' (depth to top)
6" (size) Stainless Steel (material)
(6) pump 50 (HP) 620 (yield gpm)
Turbine (type power)
(7) electric log yes (yes or no)
Miss. Geo. Survey (organization running log)
(8) how well bottom plugged Wash plug

description of formations encountered	from	to
yellow clay & sand	0	21
blue dirt	21	120
fine sand	120	240
blue shale	240	320
sand	320	380
sand & dirt mixed	380	550
dirt	550	600
sandy shale	600	710
sand	710	811

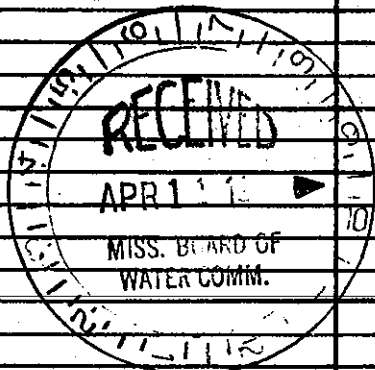

DRILLERS REMARKS: